

KANSAS


FORM 51 5M 11-44 PETROL

Ellsworth County

Section 5 Township 16 Range 10W

Well No. #2 Haska
Sohio et al

Company _____

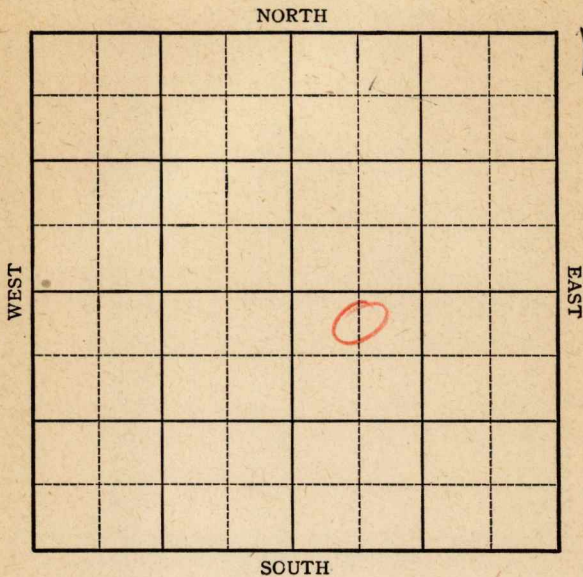

KANSAS

Ellsworth County

Sec. 5 Twp. 16 R. 10W

Well No. #2 Haska Farm


Sohio et al Company
Bloomer

330 Ft. from N. Line

_____ Ft. from S. Line

_____ Ft. from E. Line

660 Ft. from W. Line

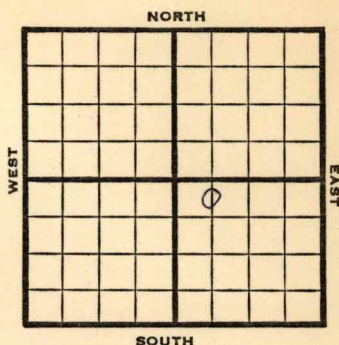

CNL NW SE

1946 **Elev. 1866** REPORT

2/6 RUR
2/14 8" - 311' Drlg. 1635'
2/21 **Arb. 3339'** T.D. 3340'
5" - 3339' RUST.
2/28 T.D. 3342' 2000 acid.
Swab 147 oil in 2½ hours.
3/7 " " "
3/13 **Arb. 3339**
5" @ 3339
2000 acid.
TD 3342'
Echo Pot. 1243
Grav. 42.6

COMPLETED

KANSASKansas Pool Name BloomerMap No. 35 Sec. 5 Twp. 16 R. 10WWell No. 2 HaskaSohio etal.

Company

FIRST REPORT

Contractor

C N L NW SE

SECTION PLAT

330 Ft. from N. Line Ft. from S. Line Ft. from E. Line660 Ft. from W. Line

		0	

Ellsworth CountyLocation Rig up

Drilling and Remarks:

R U R

RECORD

Cased in., ft.Sand Gas Oil Total Depth

PRODUCTION

1st 24 hrs. Nat. 1st 24 hrs. after shot Gas Cu. Ft.Dry Hole Abandoned

Date

FEB 6 1946

19

S. J. LEWIS

Scout

KANSAS

Kansas


Pool Name BloomerMap No. 55 Sec. 5 Twp. 16 R. 10WWell No. 2 HaskaSohio et al.

Company

COMPLETED

Contractor

C N L NW SE

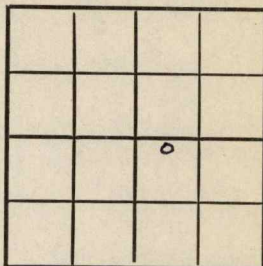E. 1866
SECTION PLAT330 Ft. from N. Line Ft. from S. Line Ft. from E. Line660 Ft. from W. LineEllsworth CountyLocation Rig up

Drilling and Remarks:

Cr 33395" 33392000 acidEchd P 8/24342 6/4

RECORD

Cased in., ft.Sand Gas Oil Total Depth 3342

PRODUCTION

1st 24 hrs. Nat. 1st 24 hrs. after shot Gas Cu. Ft.Dry Hole Abandoned

Date

MAR 13 1946

19

S. J. LEWIS

Scout