


Ellis

KANSAS

SECTION 23 TOWNSHIP 15S RANGE 17W

WELL NO. #3 John Roth

COMPANY Alpine O&R

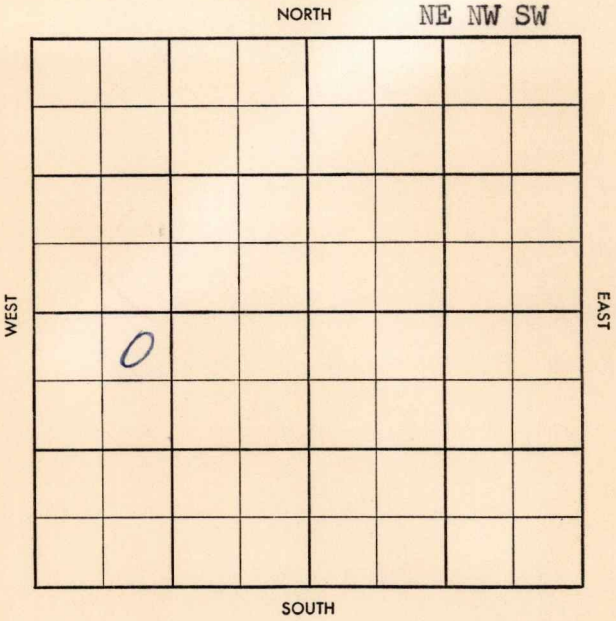

CO. ~~Ellis~~ ELEV. 19510

COMPLETE

SEC. 23 TWP. 15 RGE. 17W

COMPANY Alpine O & R NO. 3

JAN 2 '58

FARM John Roth

LOC. NE NW SW

GEOL.

CONTR. Quaker Tools

POOL Degenhart SE

SPUD 10-21-57

spudding OCT 30 '57

6" 1092/600

⌀ 3400 NOV 5 '57

A 1085 Hb 3194

TR 3214 KL 3241

DST 3245-96 60"

TP 3553

360' 5 gassy msw same oil BHP

1045/20 DST 3310-55 60"

net 68' msw BHP 928/20"

DST 3365-3400 60" 15'M

BHP 0/20" PST 3410-48 60"

300' GHP 125' 140 x 6 CM

BHP 400/20 BKCL 3470

DST 3450-75 60" 5'M

BHP 0/20" C 3508 RTD 3553

5' 2 3553/150 CD NOV 17 '57

37/3433-42 18/3445-48 NO FL

11 ⌀ LD FU 1100' oil 14 hrs

⌀ 10 BOPh mw 3 hrs pop

NOV 20 '57

NOV 27 '57

DEC 4 '57

DEC 11 '57

DEC 18 '57

DEC 26 '57

JAN 2 '58

PHYP 59 BOPd NW

Lsg 3241-

CO.

LSE.

NO.

SEC.

TWP.

RGE.

