KANSAS

Russell


FORM 51 5M BRIX

Section 10 Township 14 Range 14W

Well No. #4 Newcomer

Company Stanolind

8

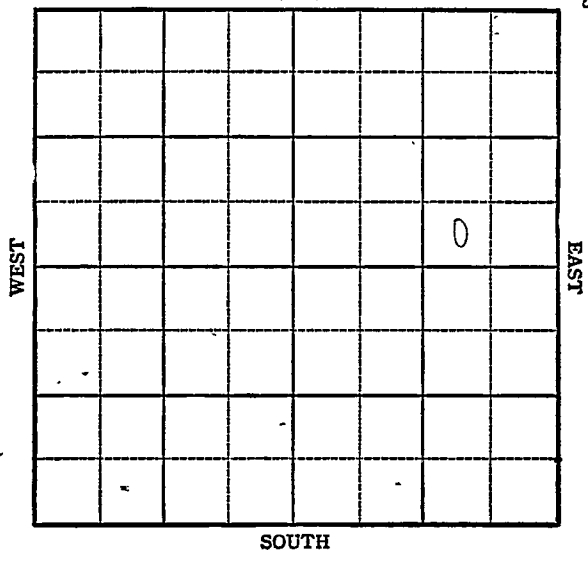

FORM 252-A
5M 9-44 PETROL

KANSAS

Sec. 10 Twp. 14 R. 14W

Well No. #4 Newcomer Farm

Stanolind Company

Williamson


____ Ft. from N. Line

330 Ft. from S. Line

990 Ft. from E. Line

____ Ft. from W. Line

Russell SW SE NE

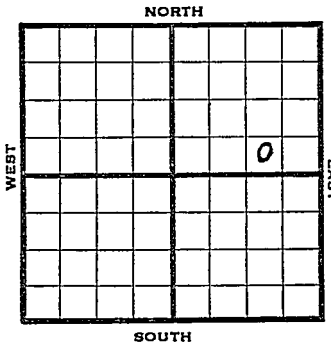

1944	REPORT
11/29	Derrick
12/6	RUR
12/14	Anhy 835 - 8" @ 845 WOC
12/21	" " " "
12/29	Topeka 3711h SS0q 2895-2908, 2908-2924. 27502979 Lans 3001 Sat 3005-3007, 3012-3015, 3023-3037 Drlg. 3136
1945 1/3	Gorham 3261 - 63 TD SO 5" @ 3261 Rust
1/10	PB 3226 12 shots 3004-08 24 shots 3011-16 500 acid 1500 acid water squeeze Perf
1/17	PB 3057 - 24 shots 3040-46 SSO 2500 acid swb 3½ W ph squeeze
1/26	36 shots 3208-3290 Sooy 3259 700' oil
1/31	" " " "
2/7	" " " "
2/14	" " " "
2/21	" " " "
2/28	" " " "

OVER

1945

3/7 36 shots 3208-70
SOOY 3259
700' oil

3/14 " "

3/23 " "

3/28 Gorham 3261
5" @ 3261
TD 3263'

ABANDONED

FORM 56 200 BKS, 1-44 PETROL

Pool Name Williamson

Map No. 12 Sec. 10 Twp. 14 R. 14W


Well No. 4 Newcomer

Stanolind Company

FIRST REPORT Contractor

SW SE NE

SECTION PLAT

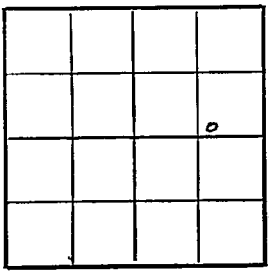

Ft. from N. Line

330 Ft. from S. Line

990 Ft. from E. Line

Ft. from W. Line

Russell

Location

Rig up

Drilling and Remarks:

derrick

RECORD

Cased in, ft.

Sand

Gas

Oil

Total Depth

PRODUCTION

1st 24 hrs. Nat.

1st 24 hrs. after shot

Gas Cu. Ft.

Dry Hole

Abandoned

Date

NOV 2 9 1944 19

S. J. LEWIS Scout

FORM 26 200 BKS. 2-44 PETROL

Pool Name Williamson

Map No. 72 Sec. 10 Twp. 14 R. 14W


Well No. 4 Newcomer

Stanolind Company

ABANDONED Contractor

SW SE NE

SECTION PLAT

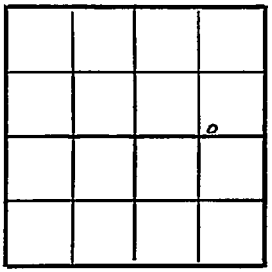

____ Ft. from N. Line

330 Ft. from S. Line

990 Ft. from E. Line

____ Ft. from W. Line

Russell

Location

Rig up

Drilling and Remarks:

Set 6 3/4" @ 3261

5" @ 3261

RECORD

Cased ____ in., ____ ft.

Sand

Gas

Oil

Total Depth @ 3263

PRODUCTION

1st 24 hrs. Nat.

1st 24 hrs. after shot

Gas ____ Cu. Ft.

Dry Hole

Abandoned

Date

MAR 28 1945 19 ____ S. J. LEWIS Scout