Ellis

KANSAS


SECTION 23 TOWNSHIP 15S RANGE 17W

WELL NO. #4 John Roth

COMPANY Alpine O&R

NORTH

SW NE NW SW

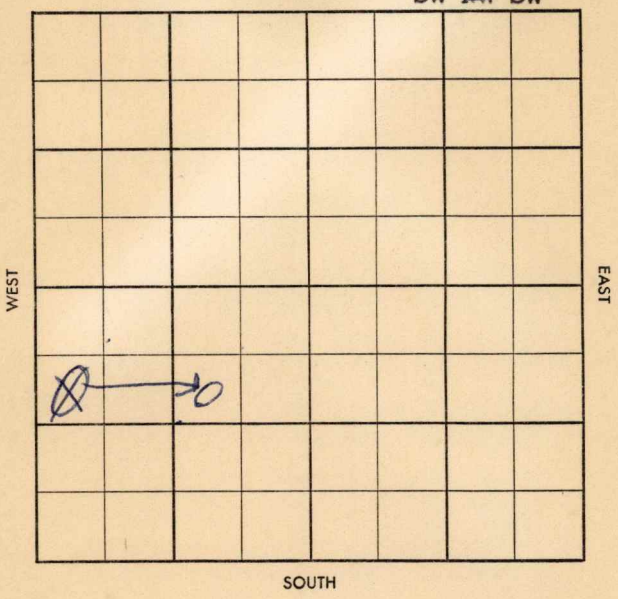

FORM 504-3 SUNRAY

CORRECTION

S-513-A

CO. Ellis ELEV. 1960DF

SEC. 23 TWP. 15 RGE. 17W

COMPANY Alpine O & R NO. 4

FARM John Roth

LOC. ~~SW NW SW~~ SW NE SW

1963 RB

COMPLETE

FEB 26 '58

H 3202
TR 3221
L 3251
Blc 3482
C 3532
Hb 3588

TD 3556

GEOL.

CONTR. Quaker Drlg. tools

POOL Degenhart SE

SPUD 1-6-57

Location JAN 8 '58

Ø760 JAN 15 '58 8"

1102/550 Ø3430

JAN 22 '58 DST 3258

-3300 61" 1440

Sip 570' MW & gcm FPO-90 BHP 1150 -840/30 DST 3370-3420 60" 7'M BHP 1020 DST 3420-56 60" 780' Sip 280 VHO & gcm FP 32-80 BHP 365-340/20 DST 3458 -76 60" 8'M BHP 1040 molay 5½ 3552/150 CO

JAN 29 '58 DD 3561 TD FU 500'O NW 14hrs (½) FU 3750 i/ NW 14hrs

$ 1380 NW 8hrs ↑ $6

1380 NW 34hrs FEB 5 '58 FEB 12 '58

FEB 19 '58 FEB 26 '58 PhyP 1820 pd

NW Gr 34.9°

CO. LSE. NO. SEC. TWP. RGE.

S-513-A

CO. Ellis ELEV.

SEC. 23 TWP. 15 RGE. 17W

COMPANY Alpine O & R NO 4

JAN 2 '58

FIRST REPORT

FARM John Roth

LOC. SW NW SW

GEOL.

CONTR. Quaker Drlg. tools

POOL Degenhart SE

SPUD

~~Location~~

CO. LSE. NO. SEC. TWP. RGE.

K-14