


Russell **KANSAS**

Section 7 Township 14 Range 14W

Well No. #1 Braun (A)

Company G. E. Ash

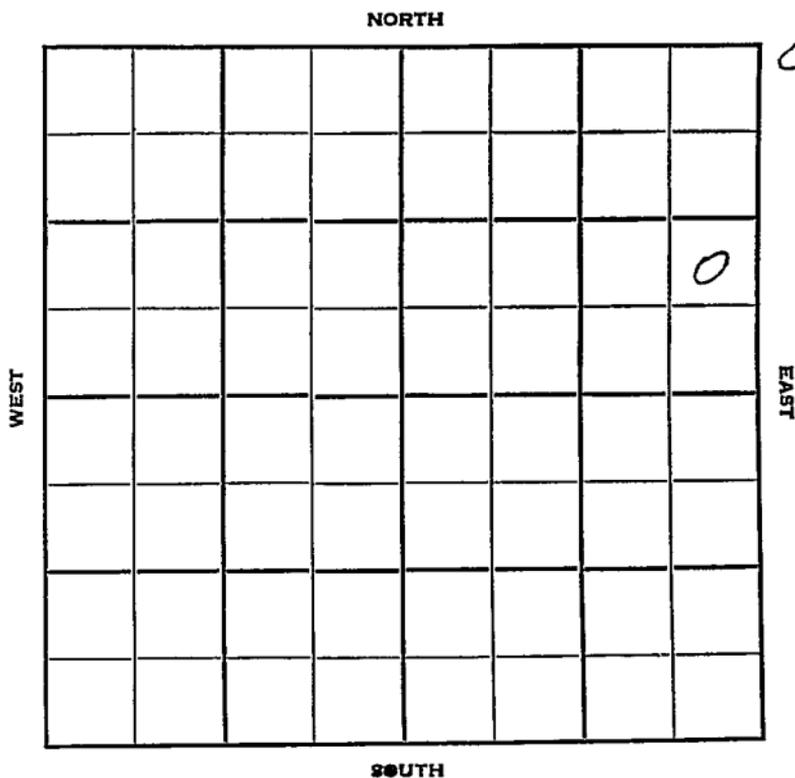

Sec. 7 Twp. 14 R. 14 W

Well No. # 1 Braun "(A)" Farm

C. E. Ash Company

Ash Contractor


Ft. from N. Line

990 Ft. from S. Line

330 Ft. from E. Line

Ft. from W. Line

NE SE NE

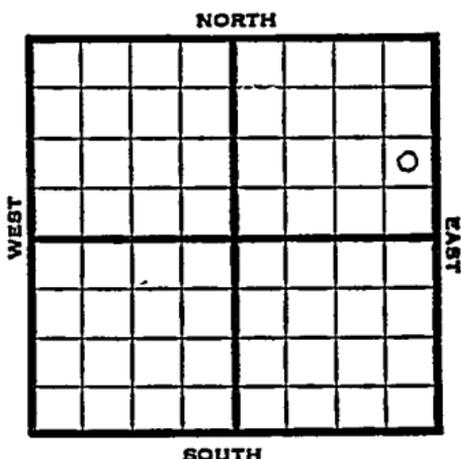

1951

Elev. 1897'

REPORT

6/13

Location

7/3

Spud 6-16-51 D & A TD 3353'
 8" @ 221 Anhy 896-955' Top 2789'
 Heeb 3015' Tor. 3033' KC 3071'
 Regan 3334'
 DST 3334-41 failed
 DST 3323-41 open 1hr. rec 130' water
 Granite 3346-53' TD
 D & A

ABANDONED


County Russell State Kansas

Sec. 7 (Blk. Twp.) 14 (Sur. Rge.) 14W Map No.

Operator C. E. Ash

Well No. 1 Farm Brown "A"

Elev. 1897 Location NE SE NE

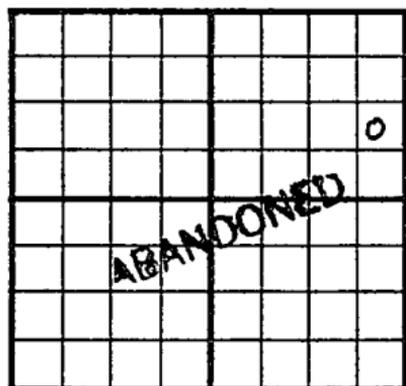

990 Ft. From S Line NE
330 Ft. From E Line Quarter

Ist. Report

Completion JUL 3 1951

Remarks

Ash - Contr.

Spudding Date 6-16-51

Drlg. Data D & A TD 3353

8" @ 221 Anhy 896-955 Top. 2789

Heeb. 3015 Tor. 3033 KC 3071

Regan 3334 DST 3334-41 failed

DST 3323-41 open 1 hr. Rec. 130' water

Granite 3346-53 TD

D & A