

KANSAS Russell


Section 7 Township 14 Range 14W

Well No. 1 Krug "B"

Company Alva Billings

Hall-Gurney Pool

NORTH

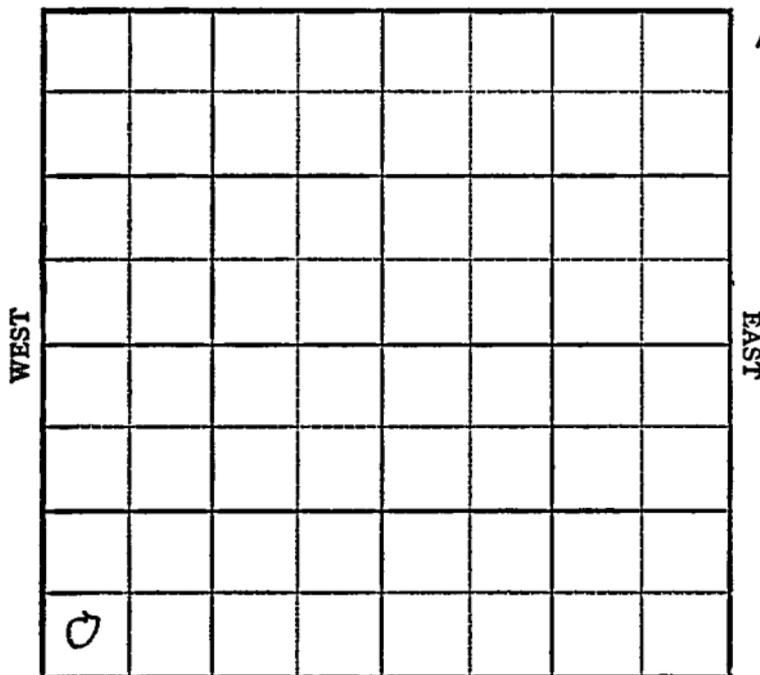

SOUTH

Sec. 7 Twp. 14 R. 14-W

Well No. #1 Krug "B" Farm

Alva Billings Company  
Hall-Gurney


\_\_\_\_\_ Ft. from N. Line

330 Ft. from S. Line

\_\_\_\_\_ Ft. from E. Line

330 Ft. from W. Line

SW/C

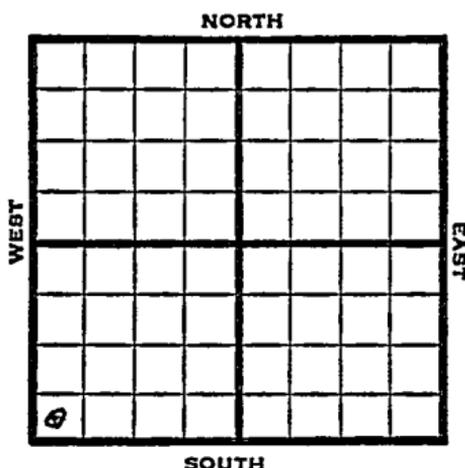

1948		REPORT
	Eli 1876'	
9/29	Cable	
10/6	Rig	
10/13	"	
10/19	15"@ 335'	
	Drlg 445'	
10/26	13"@ 530'	
	10"@ 940'	
	Drlg	
11/3	Drlg. 1785'	
11/10	Drlg. 2510'	
11/16	8" @ 2518'	
	Drlg. 3040'	
11/23	Lansing 3048'	
	Drlg 3100'	
	7"@ 3100'	
12/1	TD 3326'	
	Arb. 3309'	
	Aband.	
	<b>ABANDONED</b>	

Map No. \_\_\_\_\_ Sec. 7 Twp. 14 R. 14W

Well No. 1 Krug "B"

Alva Billings Company

**FIRST REPORT** Contractor

SW/C

SECTION PLAT

\_\_\_\_\_ Ft. from N. Line

330 Ft. from S. Line

\_\_\_\_\_ Ft. from E. Line

330 Ft. from W. Line


Russell County

Location \_\_\_\_\_

Rig up \_\_\_\_\_

Drilling and Remarks:

Cable

RECORD

Cased \_\_\_\_\_ in., \_\_\_\_\_ ft.

Sand \_\_\_\_\_

Gas \_\_\_\_\_

Oil \_\_\_\_\_

Total Depth \_\_\_\_\_

PRODUCTION

1st 24-hrs. Nat. \_\_\_\_\_

1st 24 hrs. after shot \_\_\_\_\_

Gas \_\_\_\_\_ Cu. Ft.

Dry Hole \_\_\_\_\_

Abandoned \_\_\_\_\_

Date

SEP 29 1948 19

S. J. LEWIS Scout

