


Section 7 Township 14 Range 14-W

Well No. #1 Milberger

Company Fred Rust

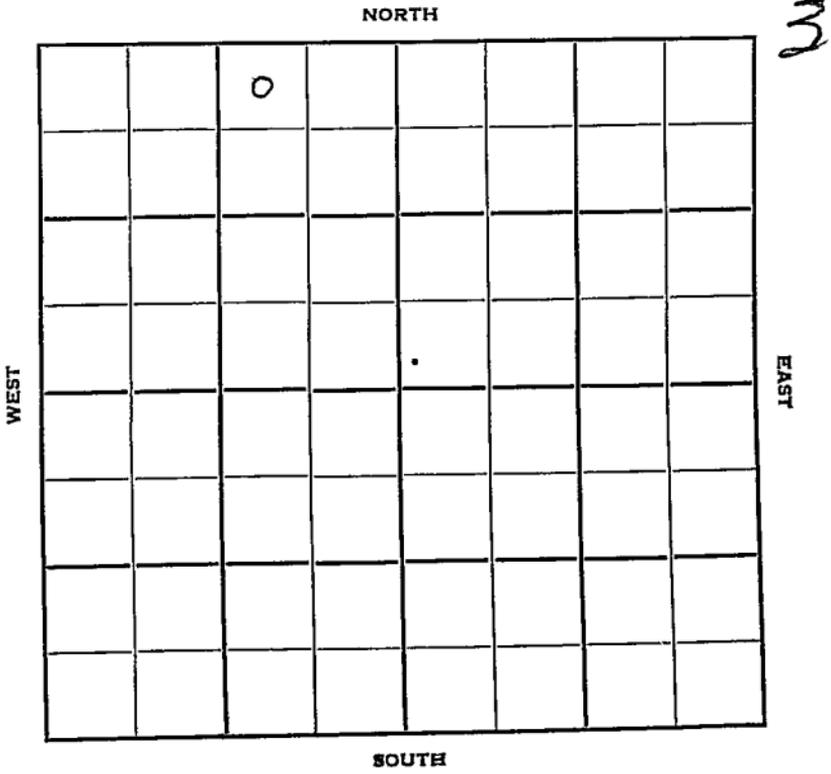

Sec. 7 Twp. 14 R. 14-W

Well No. #1 Milberger Farm

Fred Rust Company

Braden Drlg. Contractor

Hall-gurney


330 Ft. from N. Line

\_\_\_\_\_ Ft. from S. Line

990 Ft. from E. Line

\_\_\_\_\_ Ft. from W. Line

NW NE NW

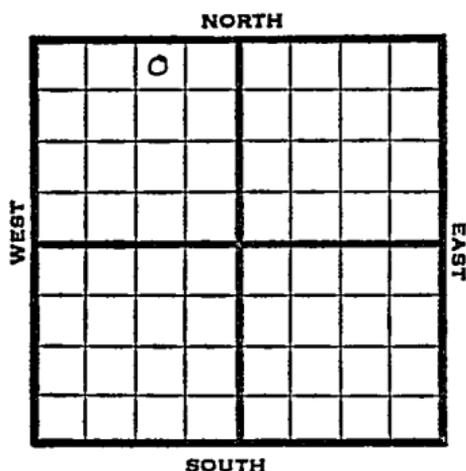

1950

Elev 1891

REPORT

7/19

Spud 7-15-50  
8" @ 174  
Drlg 1820

10/4

8" @ 174  
Top 2777  
Gorham 3315-16  
5" @ 3315  
TD 3316  
Comp 40 bopd  
Completed  
**COMPLETED**

Lans 3061

Kansas

Map No. \_\_\_\_\_ Sec. 7 Twp. 14 R. 14W

Well No. 1 Milberger

Fred Rust Company

Braden Drlg. Contractor

NW NE NW

330 Ft. from N. Line

\_\_\_\_\_ Ft. from S. Line

990 Ft. from E. Line

\_\_\_\_\_ Ft. from W. Line

SECTION PLAT

	P		
FIRST REPORT			

Russell County

Location \_\_\_\_\_

Rig up \_\_\_\_\_

Drilling and Remarks:

Spud 7-15-50

8" @ 174

drlg. 1820

RECORD

Cased \_\_\_\_\_ in., \_\_\_\_\_ ft.

Sand \_\_\_\_\_

Gas \_\_\_\_\_

Oil \_\_\_\_\_

Total Depth \_\_\_\_\_

PRODUCTION

1st 24 hrs. Nat. \_\_\_\_\_

1st 24 hrs. after shot \_\_\_\_\_

Gas \_\_\_\_\_ Cu. Ft.

Dry Hole \_\_\_\_\_

Abandoned \_\_\_\_\_

Date

JUL 19 1950

19

J. E. TYRA

Scout

County Russell State Kansas

Sec. 7 (Blk. 14) (Sur. 14W) Map No.

Operator Fred Rust

Well No. 1 Farm Milberger

Elev. 1891 Location NW NE NW

	0				

330 Ft. From N Line NW

990 Ft. From E Line Quarter

Ist. Report

Completion OCT, 4 1950

Remarks Hall-Gurney Pool

Braden Drlg. - Contr.

Spudding Date 7-15-50

Drlg. Data Oil well TD 3316

8" @ 174 Top. 2777 Lans. 3061

Gornam 3315-16 5" @ 3315 TD 3316

Comp. 40 bopd

J. E. TYRA