


Section 7 Township 14 Range 14-W

Well No. #1 Speere

Company Witt

NORTH **Millberger Pool**

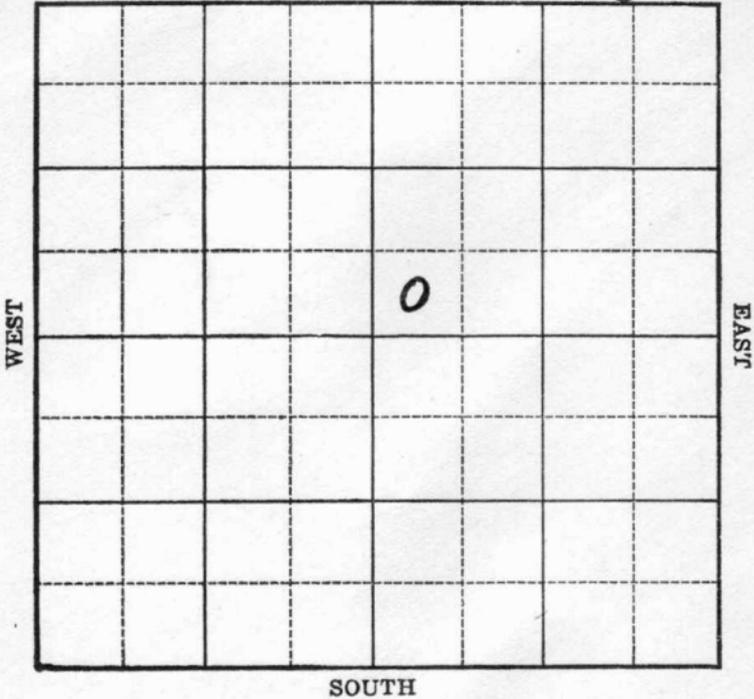

Sec. 7 Twp. 14 R. 14W

Well No. #1 Speere Farm _____

Witt Company _____

(Millberger Pool)


_____ Ft. from N. Line

330 Ft. from S. Line

_____ Ft. from E. Line

330 Ft. from W. Line

Elev. 1896

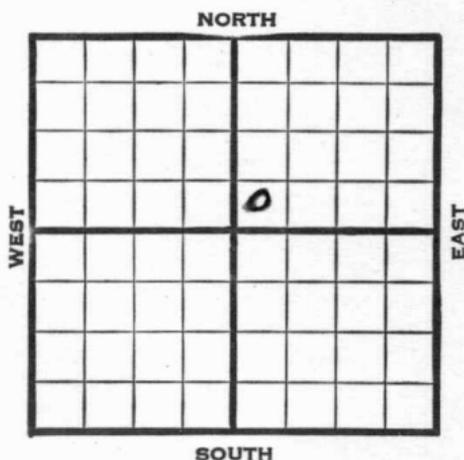

1939	REPORT
6/7	Cable rig
6/16	" "
6/23	Rigging up.
6/29	20" - 20' 15" - 351'
	Drlg. 540'
7/6	12½" - 621' 10" - 912'
	Anhy 909' Drlg. 1440'
7/13	Drlg. 2300'
7/20	8" - 2523' Drlg. 2820'
7/27	Lans. 3082' 8½" - 3082½'
	Drlg. 3096'
8/3	Pay 3108-12 & 3168-70' T.D.
	400' fluid 12 hours.
8/9	Lans. 3082'
	8" - 3082½'
	T.D. 3170'
	8000 acid.
	Potential 1310 bbls., pump.
	COMPLETED

KANSAS

Russell

Map No. _____ Sec. **7** Twp. **14** R. **14W**

Well No. **1 Speere**

Witt

Company _____

Contractor _____

FIRST REPORT

SW NE

_____ Ft. from N. Line

330 Ft. from S. Line

_____ Ft. from E. Line

330 Ft. from W. Line

MILLBERGER POOL

SECTION PLAT

		o	

Location _____

Rig up _____

Drilling and Remarks:

Cable Rig

RECORD

Cased _____ in., _____ ft.

Sand _____

Gas _____

Oil _____

Total Depth _____

PRODUCTION

1st 24 hrs. Nat. _____

1st 24 hrs. after shot _____

Gas _____ Cu. Ft.

Dry Hole _____

Abandoned _____

Date

JUN 7 1939 19

S. J. LEWIS Scout

Russell KANSAS

Map No. 72 Sec. 7 Twp. 14 R. 14W

Well No. 1 Speere

Witt

Company

Contractor

COMPLETED

SW NE

SECTION PLAT

_____ Ft. from N. Line

330 Ft. from S. Line

_____ Ft. from E. Line

330 Ft. from W. Line

MILLBERGER POOL

Location _____

RECORD

Rig up _____

Cased _____ in., _____ ft.

Drilling and Remarks:

Sand _____

Gas _____

Lans. 3082.

Oil _____

8" C 3082 1/2

Total Depth 3170

8000 Acid

PRODUCTION

Pump 1310 P.T.

1st 24 hrs. Nat. _____

1st 24 hrs. after shot _____

Gas _____ Cu. Ft.

Dry Hole _____

Abandoned _____

Date

AUG 9 1939

S. J. LEWIS

Scout