

Sec. 33 Twp. 16 R. 8 W

Well No. # 1 Ward Farm _____

Continental Oil Company _____

Lohman & Johnson Contractor _____

Andrews Pool

_____ Ft. from N. Line

330


_____ Ft. from S. Line

_____ Ft. from E. Line

330

_____ Ft. from W. Line

SW SW SW

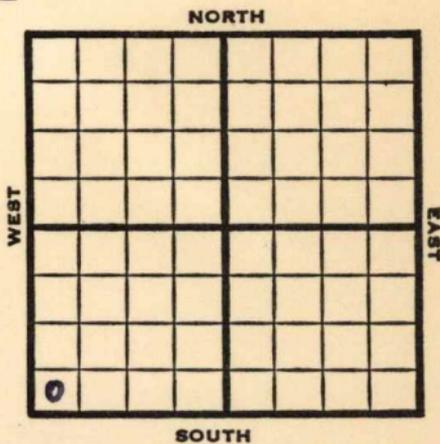

1953

Elev. 1679'

REPORT

3/18

Location

3/26

10" @ 326, Drlg. 2130'

4/2

Schl tops: **Heeb 2604'** **Br 11 2724'**
Lans. 2743' **B KC 3092'** **V 3169'**
Simp 3227' **Arb. 3277'**

4/9

RTD ~~31~~ 3283' 5" @ 3278'
 CO 3283' FU 500' fluid 1 hr.
 S/50 BO 2 hrs.

4/15

Spud 3-20-53
 Oil Well
 TD 3283
 10" @ 326
Heeb 2604, Br line 2724, Lans 2743,
B KC 3092, Viola 3169, Simp 3227,
Arb 3277
 TD 3283
 5" @ 3278
 CO to 3283, FU 500' fluid 1 hrs.,
 S/50 bo 2 hrs.
 Comp. 319 bopd 35 bw

COMPLETED

