


Map No. Russell KANSAS Sec. 7 Twp. 14 R. 14^W

Well No. 1- Wandt Farm Imo Oil & Gas Company

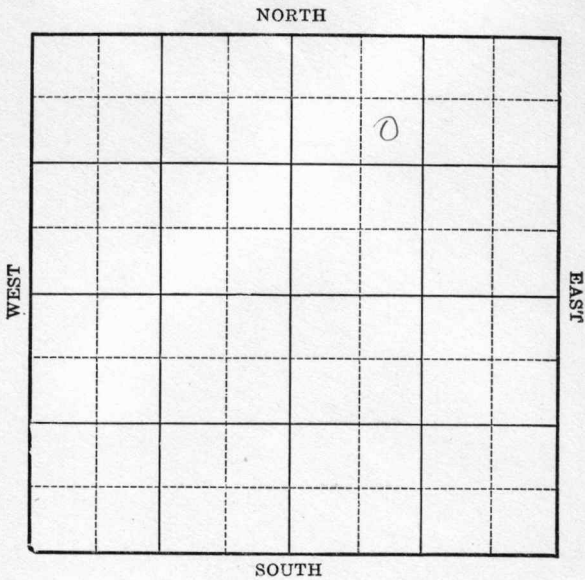

Location _____
Drilling Remarks _____

Rig Up _____
Drilling Remarks _____

RECORD


Cased _____ in. _____ ft.
Sand _____
Gas _____
Oil _____
Total Depth _____

PRODUCTION

1st 24 hrs. Nat. _____
1st 24 hrs. after shot _____
Gas _____ cu. ft. _____
Dry Hole _____
Abandoned _____

Map No. Russell KANSAS Sec. 7 Twp. 14 R. 14^w
 Well No. 1 - Waudley Farm
Low Oil & Gas Company

NORTH

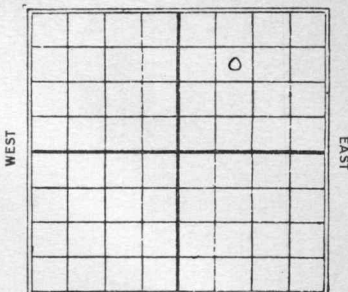

SOUTH

940 Ft. from N. Line

_____ Ft. from S. Line

_____ Ft. from E. Line

940 Ft. from W. Line

1930

Date

REPORT

3/26	Loc.
4/2	
4/9	Bldg. rig.
4/16	Rig up.
4/23	Bldg. 470'
4/30	" 800'
5/7	" 1305'
5/14	" 1880'
5/21	" 2280'
5/28	" 2530' show
	gas 2501-15'
6/4	U.R. 8" 2675'
6/11	U/R 6" 3009'
6/18	Top Oswald 3050'
	T.D. 3160 U.R. 6"
6/25	S.D. 3328' HFW
7/2	TD 3328
	Dry & Abandon

Map No. KANSAS Sec. 7 Twp. 14 R. 14W

Well No. 72 1 Handy

Imo. Oil & Gas Company

Contractor

SECTION PLAT

		o	

990 Ft. from N. Line

.....Ft. from S. Line

.....Ft. from E. Line

990 Ft. from W. Line

FIRST REPORTS

Location ✓

Rig up

Drilling and Remarks:

RECORD

Cased.....in.,ft.

Sand

Gas

Oil

Total Depth

PRODUCTION

1st 24 hrs. Nat.

1st 24 hrs. after shot

GasCu. Ft.

Dry Hole

Abandoned

Date

.....192..... S. J. LEWIS Scout

Map No. KANSAS Sec. 7 Twp. 14 R. 14 W

Well No. 1 Handley

Imo Oil & Gas. Company

Contractor

SECTION PLAT

		0	

990 Ft. from N. Line

_____ Ft. from S. Line

_____ Ft. from E. Line

990 Ft. from W. Line

ABANDONED

Location _____

Rig up _____

Drilling and Remarks:

RECORD

Cased _____ in., _____ ft.

Sand _____

Gas _____

Oil _____

Total Depth 3328

PRODUCTION

1st 24 hrs. Nat. _____

1st 24 hrs. after shot _____

Gas _____ Cu. Ft.

Dry Hole _____

Abandoned _____

Date

JUL 2 1930

S. J. LEWIS

Scout