


DX 78-1 Ellis

KANSAS

Section 29 Township 15 Range 17W

Well No. 1 Schiefelbein

Company C R A

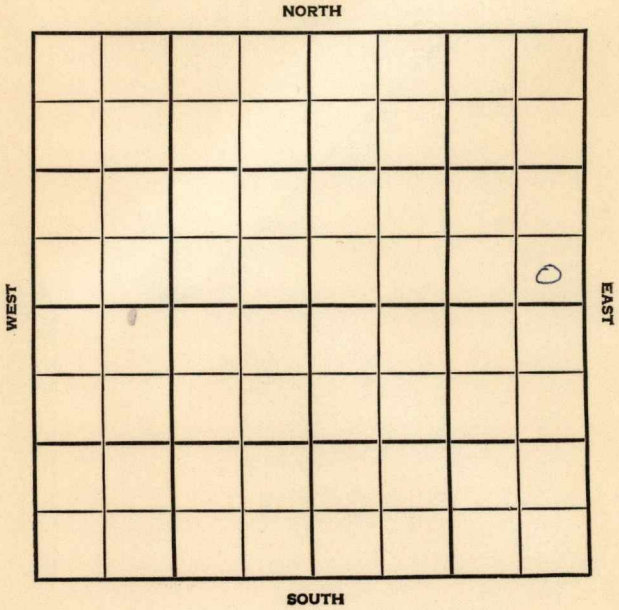

HOT FILE

Ellis

KANSAS


SEC.	TWP.	R.
29	15	17W

WELL NO. #1 Schiefelbein FARM

COMPANY C R A

CONTRACTOR Co. Tools.

_____ Ft. from N. Line
 330 _____ Ft. from S. Line
 330 _____ Ft. from E. Line
 _____ Ft. from W. Line

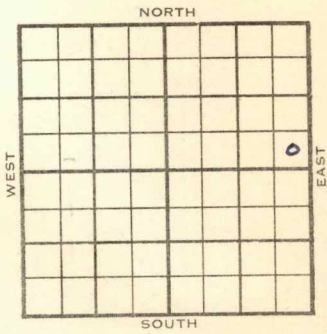

SE SE NE
 (offset Sunray)

	ELEVATION	REPORT
1955	1957' DF	
4/27	Spud 4-23-55 13" @ 308' WOC.	
5/26	failed to rec load, Sp 3542, 24/3526-32, S/58.57 go in 12 hr, tr of wtr, frac, swbg load	
6/2	S/av. 13.53 BO + 25.66 BWPH. POP 147 BF, 17% oil in 12 hr. Tstg.	
6/9	P/50 BO 77 BW 12 hr. P/96 BO 151 BW 24 hrs.	
6/16	P/81.61 BO 122 BW 22 hr. P/56 BO 104 BW 24 hr.	
6/22	P/42.55 BO 63 BW 24 hr. P/87 BO 142 BW 24 hrs.	
6/30	No report	
7/7	P/69 BF, 41% wtr. Waiting on potential	
7/14	P/57 1/2 bopd, 70% wtr, waiting on pot.	
7/22	No report	
7/28	P/65 bo, 65% wtr. waiting on pot.	

OVER OVER OVER

1955

8/3

Comm 4-23-55

TP	2981
H 3210	3212
Tr	3230
L 3263	3264
BKC 3474	3489
C	3525
A 3574	3574

TD 3605

13" @ 308/250 8 5/8" @ 1107/550

DST 3150-66 open 1 hr Rec 70' msw

800/20" DST 3529-53 open 1 hr.

Rec 2135' hocsw 1030/20" DST 3550-

53 open 1 hr Rec 30' hocm 1050/20"

TD 3605 5 1/2" @ 3605 30/3550-55

B/4 bo 1 hr FU 300' oil 2 hr frac

SP 3542 PB 3535 24/3526-32

B/58.57 go 12 hr. frac S/13.53 bo

25/66 bwph P/147 bf 17% oil 12 hr.

P/50 bo 77 bw 12 hr P/96 bo

151 bw 24 hr P/81.60 bo 122 bw 22 hr

P/56 bo 104 bw 24 hr.

Comp 90 bopd 70% wtr.

COMPLETED

County Ellis Elev. 1957
 Sec. 29 Twp. 15 Rgs. 17W
 Company C R A
 Farm Name Schiefelbein No. 1

TOPS	DEPTH	LOG	DATUM	Loc. in Sec.
Anh.				SE SE NE
Tr.				
H.	3210	3212	1255	
Dg.		3230	1273	
Bl.				Geol.
L.	3263	3264	1307	
K.C.				Contr.
B.K.C.	3474	3489	1532	
Ce.				Pool
C.		3525	1568	
M.				
M.				
K.				
Mz.				
Mq.				
V.				
S.				
S.				
A.	3574	3574	1617	
R.				
PE.				
G.				
TD.	3605			

Date Comm. 4-23-55 AUG 3 1955
 13" @ 308/250 8 5/8" @ 1107/550
 DST 3150-66 open 1 hr. Rec. 70' msw
 800/20" DST 3529-53 open 1 hr.
 Rec. 2135' hocsw 1030/20" DST 3550-53
 open 1 hr. Rec. 30' hocm 1050/20"
 TD 3605 5 1/2" @ 3605 30/ 3550-55
 B/ 4 bo 1 hr. FU 300' oil 2 hr. frac
 SP 3542 PB 3535 24/ 3526-32

B/ 58.57 go 12 hr. frac S/ 13.53 bo
25/66 bwph P/ 147 bf 17% oil 12 hr.
P/ 50 bo 77 bw 12 hr. P/ 96 bo
151 bw 24 hr. P/ 81.61 bo 122 bw
22 hr. P/ 56 bo 104 bw 24 hr.
Comp. 90 bopd 70% wtr.

Scout Cards
Land Small Map
Land Wall Map
Tracings
France Map
Pierce Map
Misc

mm

AUG 10 1955