


Kingman

KANSAS

SECTION 20 TOWNSHIP 30 RANGE 7 W

WELL NO. #1 Schuman

COMPANY Champlin Ref.

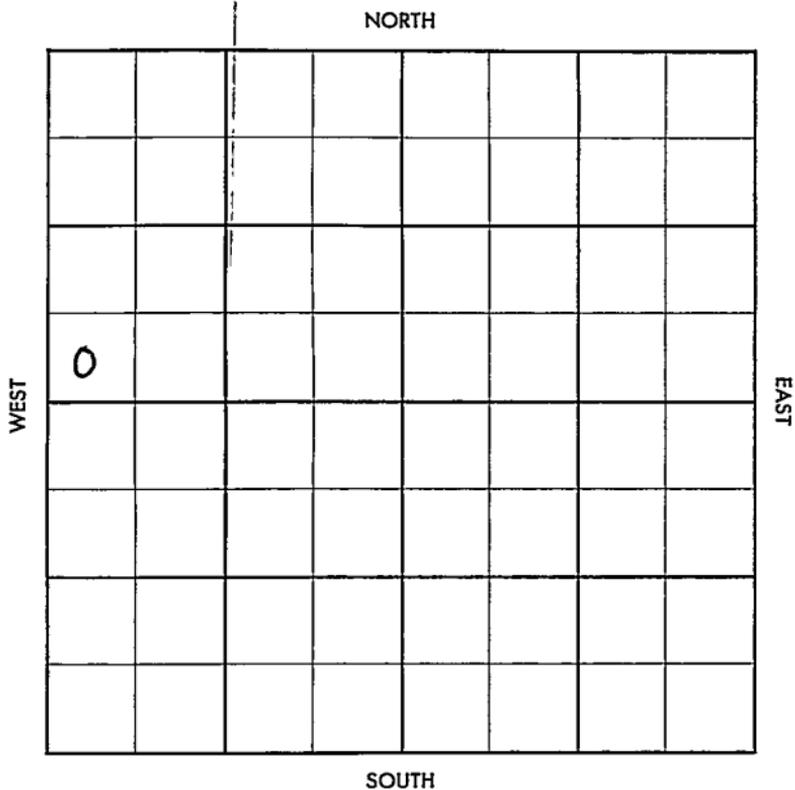

1

12-8 F/ 54 bo 24 hrs.
12-22 Waiting on Portential
12-21 Comp. F/ 55 bopd
TD 4454'

COMPLETED

County Kingman Elev. _____
 Sec. 20 30 Rge. 7W
 Company Champion Ref.
 Farm Name Schuman No. I

TOPS	DEPTH	LOG	DATUM
Anh.			
Tp.			
H.			
Tr.			
Dg.			
Bl.			
L.			
K.C.			
B.K.C.			
Ce.			
C.			
M.			
M.			
K.			
Mz.			
Me.			
V.			
S.			
S.			
A.			
R.			
Pe.			
G.			
T.D.			

Loc. in Sec. SW SW NW

Geol. _____
 Contr. Vierson & Cochran

Pool Spivey

<u>1/2 mile</u>	<u>9 3/4</u>
<u>0</u>	<u>NOW</u>

FIRST REPORT

Date Comm. 11-6-55
8" @ 343/225 d rlg. 1765

257

Co.
Lse.
No.
Sec.
T.
R.

County Kingman Elev. 1548
 Sec. 20 Twp. 30 Rge. 7W
 Company Champlin Ref.
 Farm Name Schuman No. 1

TOPS	DEPTH	LOG	DATUM	Loc. in Sec.																														
Anh.				SW SW NW																														
Tr.																																		
Dg.																																		
Bl.																																		
L.	<u>3400</u>		<u>1852</u>	Geol.																														
K.C.				Contr.																														
B.K.C.	<u>3941</u>		<u>2393</u>	Vierson & Cochram																														
Ce. <u>Mar m</u>	<u>3973</u>		<u>2425</u>																															
C.				Pool Spivey																														
M.	<u>4230</u>		<u>2682</u>																															
M.				<table border="1"> <tr><td></td><td></td><td></td></tr> </table>																														
K.																																		
Mz.																																		
Me.																																		
V.																																		
S.																																		
S.																																		
A.																																		
R.																																		
Pe.																																		
G.																																		
T.D.	<u>4454</u>			COMPLETE																														

Date Comm. 11-6-55
8" @ 343 DST 4232-61 open 40 min.

gas to surface in 11 min. 98 mcfg in
20 min. F/ oil in 28 min. 1480/20"
DST 4263-4330 open 2 hr. rec. 450' hg
& socm 390' ho & gcm 90' free oil
840/20" DST 4374-82 open 1 hr.
rec. 29' mud 25/20" DST 4340-75
open 1 hr. rec. 29' mud 83/20"
5 1/2" @ 4453/150 - CO 140/ 4240-75

S/ 96 bo 18 hr. F/ 18 bo 5 hr.

F/ 5 $\frac{1}{2}$ bo 2 $\frac{1}{2}$ hr. * Comp. F/ 55 bopd

R. G.

JAN 4 1956