


Section 28 Township 15 Range 17 W

Well No. # 1 Rajewski

Company Cook & Galloway & Sunray

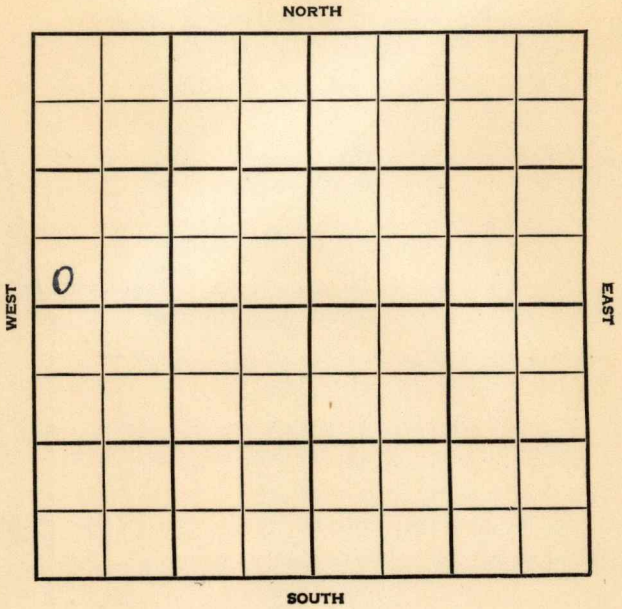

Ellis

KANSAS

|      |      |     |
|------|------|-----|
| SEC. | TWP. | R.  |
| 28   | 15   | 17W |

WELL NO.

#1 Rajewski

FARM

COMPANY

Cook & Galloway & Sunray

CONTRACTOR

C & G Drlg.

Wildcat.

Ft. from N. Line


330

Ft. from S. Line

Ft. from E. Line

330

Ft. from W. Line

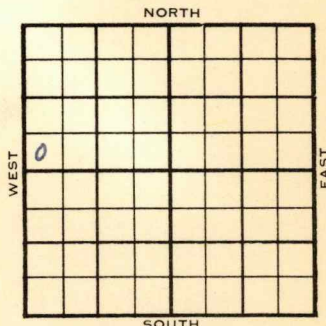

SW SW NW

Sun - support.

|      |                    |                     |
|------|--------------------|---------------------|
| 1955 | ELEVATION<br>1927' | REPORT (Wh 5 - BH1) |
|------|--------------------|---------------------|

3/16 M I R

5/25

Top 2949; Heeb 3172; Tor 3192;  
Lsg 3222; Sandy Congl 3482; Arb  
3516; TD 3520; 8" 1071;  
DST 3233-50 open 1 hr, rec 60' muddy  
wtr, 1005#;  
DST 3498-3504 open 1 hr, good blo thru  
out test, rec 23' oil and gcm, 30' ocm  
230' oil, 10' muddy sw, 1035#;  
DST 3516-20 open 1 hr, good blo, rec  
180' gas, 20' hogcm, 30' sgcmo, 120'  
oil, 980#; 5½" 3517; CO 3520; swb 3-  
4 boph; 500 A; swb 13 boph 2 hrs;  
pmp 100 bo no wtr; Pot 130 bopd no  
wtr from Arb 3517-20

COMPLETED

County **Ellis** State **Kansas**Sec. **28** (Blk. Twp.) **15** (Sur. Rge.) **17W** Map No.Operator **Cook & Galloway & Sunray**Well No. **1** Farm **Rajewski**Elev. Location **SW SW NW****330** Ft. From **S** Line **NW****330** Ft. From **W** Line Quarter1st. Report **MAR 16 1955**

Completion

Remarks **Sun - support****C & G Drlg. - Contr.**

Spudding Date

Drlg. Data **Wildcat****M I R**

FABEN GILSTRAP