


DX 78-1

Kingman KANSAS

Section 19 Township 30 Range 7W
Well No. 1 Aldrich "B"
Company Beardmore & NCRA

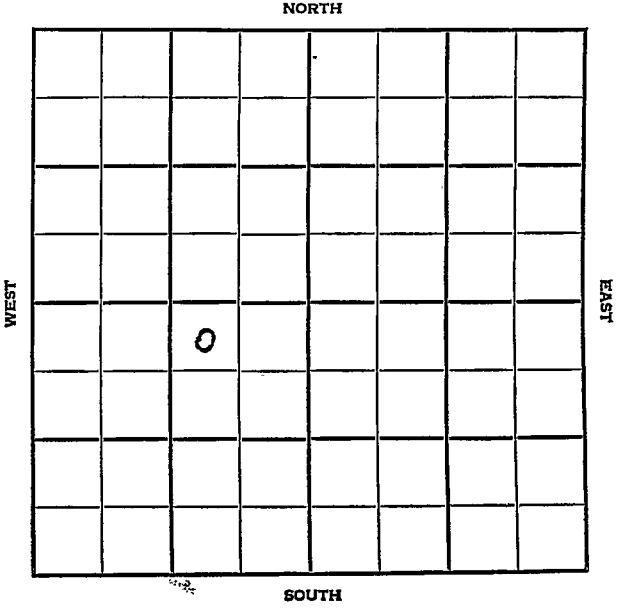

HOT FILE

Kingman

KANSAS

SEC. **HOT FILE** TWP.

R.

19

30

7W

WELL NO.

1 Aldrich "B"

FARM

COMPANY

Beardmore & NCRA

CONTRACTOR

Beardmore
Spivey Pool

330


Ft. from N. Line

Ft. from S. Line

990

Ft. from E. Line

Ft. from W. Line

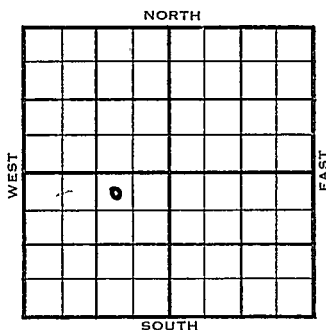

NW NE SW

(1/2 mile Sunray)

1955

ELEVATION

1544'

REPORT

4/20

MIR

5/26

F/11 boph, 2% wtr, in 48 hr

6/2

Waiting on potential

6/9

Miss 4240'. RTD 4292'

DST 4241-55 open 1 hr rec 70' GCM,
60' O & GCM, 90' HOCM, 30" muddy wtr.
1195/20".DST 4255-80 open 1/2 hr rec 60' GCM,
20' wtr. 1075/20"DST 4282-92 open 1 hr gas in 2 min
F/oil in 28 min. F/10 BOPH, 390 MCFG
1610/20". 5 1/2" @ 4284 DD 4295

F/15 BOPH 500 M-A F/15 BOPH 6 hr.

F/11 BOPH 2% wtr. 48 hr.

Comp. F/386 BOPD

COMPLETED

County Kingman ✓ Elev. 1544
 Sec. 19 Twp. 30 Rge. 7W
 Company Beardmore Drlg. & NCRA
 Farm Name Aldrich "B" No. 1

TOPS	DEPTH	LOG	DATUM	Loc. in Sec.
Anh.				NW NE SW
TP.				
H.				
Tr.				
Dg.				
BL.				
L.				Geol.
K.C.				
B.K.C.				Contr.
Ce.				<u>Beardmore</u>
C.				
M.	<u>4240</u>		<u>2696</u>	Pool
M.				<u>Spivey</u>
K.				
Mz.				
Me.				
V.				
S.				
S.				
A				
R.				
PE.				
G.				
TD.				

COMPLETE

Date Comm. 4-24-55 JUN 8 1955

8 5/8" @ 156/100 DST 4241-55 open 1 hr

Rec. 70' gcm 60' o & gcm 90' hocm

30' mw 1195/20" DST 4255-80 open

Rec. 60' gcm 120' o & gcm 130' hocm

20' wtr. 1075/20" DST 4282-92

open 1 hr. gas in 2 min. F/ oil in

28 min. F/ 10 boph 390 mcfg 1610/20"

5 1/2" @ 4284/75 DD 3295 F/ 15 boph

500 M-A F/ 15 boph 6 hr. F/ 11 boph

2% wtr. 48 hr.

Comp. F/ 386 bopd

JUN 23 1955

_____	Misc.
_____	Picture Map
_____	Trace Map
_____	Tracings
_____	Land Wall Map
_____	Land Small Map
_____	Scout Cards

Carroll