


Section 33 Township 33 Range 3 E

Well No. # 2 Auman "B"

Company Texas Company

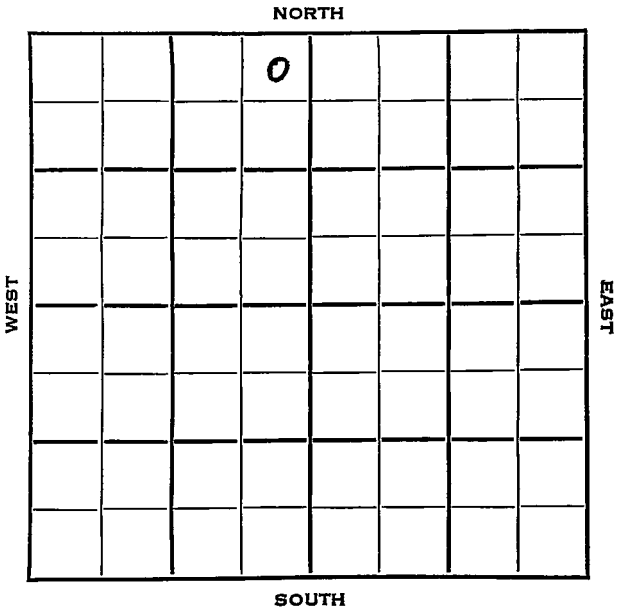

Cowley

KANSAS

SEC.	TWP.	R.
33	33	3 E
WELL NO.		FARM
# 2 Auman "B"		
COMPANY		
Texas Company		

CONTRACTOR

Laura Jane
Hower Pool


330 _____ Ft. from N. Line

_____ Ft. from S. Line

330 _____ Ft. from E. Line

_____ Ft. from W. Line

NE NE NW

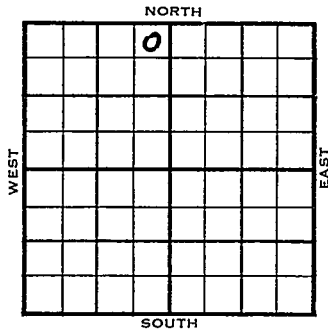

1953

ELEVATION
1111'

REPORT

11/18

Spud 11-16-53
10" @ 119 WOC

1954
1/6

Spud 11-16-53
Oil Well
TD 3317'
10" @ 119'
Bart 3276', Miss 3312'
TD 3317'
7" @ 3316'
Top 1485', Stal. 2214', KC 2606',
Layton 2612'
CO to 3312
10/3308-11
Sd-frac
S/1 bo 3½ bwph
PB 3300'
10/3292-95
Sd-oil-frac
P/40 bo 16 hrs.
Comp. 17 bopd 6 bw

COMPLETED

County Cowley State Kansas

Sec. 33 (Blk. Twp.) 33 (Sur. Rge.) 3E Map No.

Operator Texas Company

Well No. 2 Farm Auman "B"

Elev. 1117 Location NE NE NW

		0			
FIRST REPORT					

330 Ft. From N Line NW

330 Ft. From E Line Quarter

1st. Report NOV 18 1953

Completion _____

Remarks _____

Laura Jane - Contr.

Spudding Date 11-16-53

Drig. Data Flow Pool

10" @ 119 WOG

J. G. MCGEHEE

County Cowley State Kansas

Sec. 33 (Blk. 33 (Sur. 3E (Twp. Rge.) Map No.

Operator Texas Company

Well No. 2 Farm Auman "B"

Elev. 1111 Location NE NE NW

		0			

330 Ft. From N Line NW

330 Ft. From E Line Quarter

Ist. Report

Completion JAN 6 1954

Remarks Hower Pool

Laura Jane - Contr.

Spudding Date 11-16-53.

Drlg. Data Oil well TD 3317

10" @ 119 Bart. 3276 Miss. 3312

TD 3317 7" @ 3316 Top. 1485

Stal. 2214 KC 2606 Layton 2612

CO to 3312 10/ 3308-11 sd-frac

S/ 1 bo 3 $\frac{1}{2}$ bwph. PB 3300 10/ 3292-95

sd-oil-frac P/ 40 bo 16 hr.

Comp. 1.7 bopd. 6 bw