


Section 33 Township 33 Range 3E

Well No. #5 Coulson

Company Texas Company

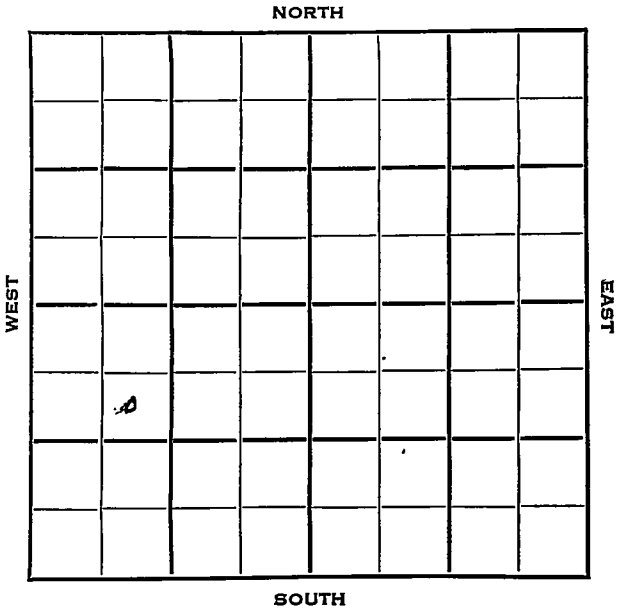

Cowley


SEC 33	TWP. 33	R. 3E	Range ✓
-----------	------------	----------	--------------------

WELL NO. #5 Coulson FARM

COMPANY Texas Company

CONTRACTOR Gueda Springs Pool

990 Ft. from N. Line
 _____ Ft. from S. Line
 _____ Ft. from E. Line
 990 Ft. from W. Line

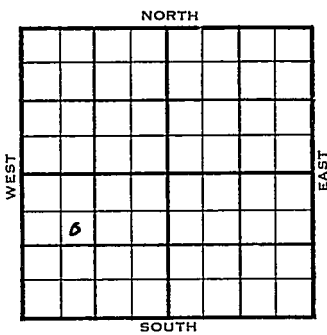

SE NW SW

	ELEVATION	REPORT
1954	1108'	
2/17	Location	
3/31	Spud 3-18-54 D & A TD 3329 10" @ 117 Stal. 2221 Lans. 2312 KC 2616 Layton 2638 Bart 3258 Bart sd. 3278 DST 3050-65 open 1 hr rec 20' mud 55# TD 3329' D & A	
	ABANDONED	

County Cowley State Kansas

Sec. 33 (Blk. 33 (Sur. Rge.) 3E Map No.

Operator Texas Company

Well No. 5 Farm Coulson

Elev. 1108 Location SE NW SW

ABANDONED					

990 Ft. From N Line SW

990 Ft. From W Line Quarter

1st. Report

Completion MAP # 1 1954

Remarks Gueda Springs Pool

Spudding Date 3-18-54

Drig. Data D & A TD 3329

10" @ 117 Stal. 2221 Lans. 2312

KC 2616 Layton 2638 Bart. 3258

Bart. sd. 3278 DST 3050-65 open 1 hr.

Rec. 20' mud 55# TD 3329

D & A