


Section 8 Township 29 Range 6E

Well No. #3 Carl Wakefield

Company Dunn & Strait & Eldorado Pegg.

NORTH

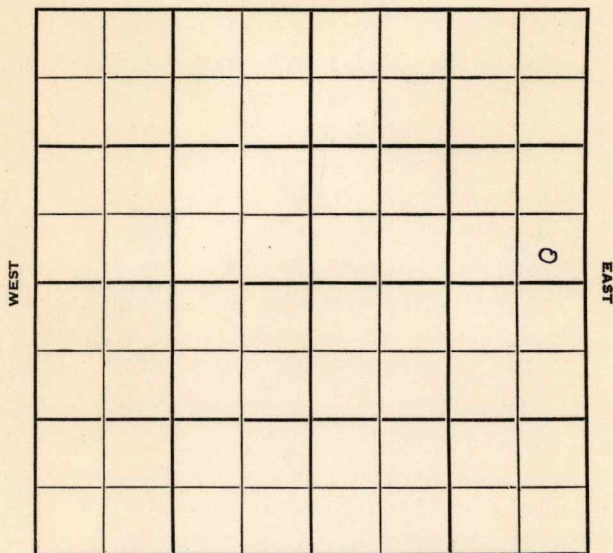

SOUTH

WEST

EAST

Butler


KANSAS

Sec. 8 Twp. 29 R. 6E

Well No. #3 Carl Wakefield Farm
Dunn & Strait & Eldorado Refg. Company

Semisch Contractor

Ft. from N. Line
330
Ft. from S. Line
330
Ft. from E. Line
Ft. from W. Line
SE SE NE

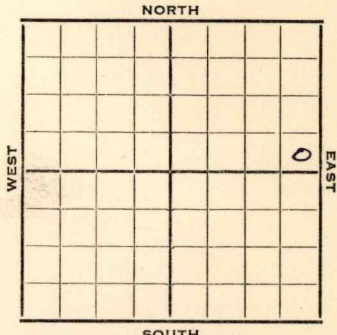

1952 Elev. 1422' REPORT

4/2
5/13

Location
Spud 4-4-52
Oil Well TD 2842' 8" @ 100'
Bart. 2783 TD 2825
5" @ 2822' DD 2827
Miss. Li 2838 DD 2842
PB 2838 Hydro
Comp. 25 bopd

COMPLETED

County **Butler** State **Kansas**

Sec. **8** (Blk.) **29** (Sur.) **6E** Map No.

Operator **Dunn & Strait & Eldorado Refg.**

Well No. **3** Farm **Carl Wakefield**

Elev. Location **SE SE NE**

FIRST REPORT

330 Ft. From **S** Line **NE**

330 Ft. From **E** Line Quarter

Ist. Report **APR 2 1952**

Completion

Remarks

Spudding Date

Drlg. Data **Semisch**

Location

J. G. McGEHEE

