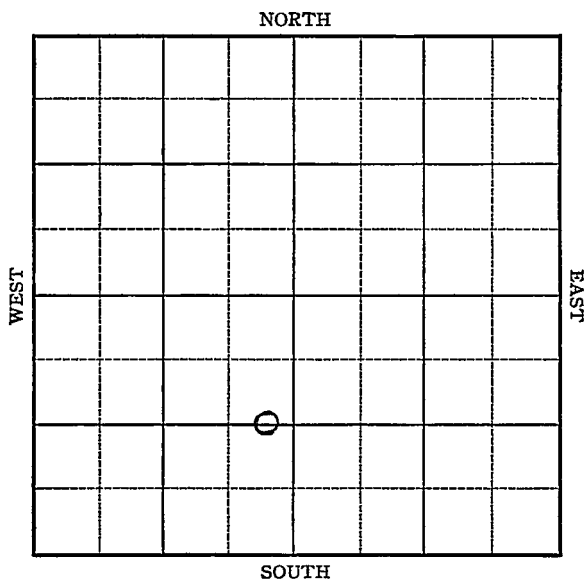



Section 8 Township 16 Range 13-WWell No. 5 BitterCompany T. C. Johnson

Sec. 8 Twp. 16 R. 13-WWell No. #5 Bitter FarmT. C. Johnson

Company

 Ft. from N. Line1320 Ft. from S. Line330 Ft. from E. Line Ft. from W. Line

Elev. 1931'.

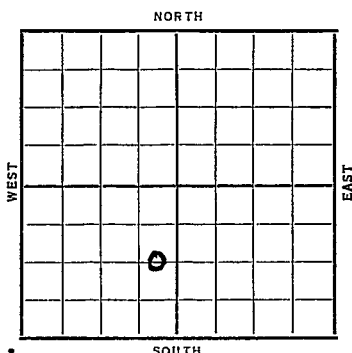

Date

REPORT

1938

1/12

Cellar.

1/20

R.U.R.

1/28

10"- 630' WOC.

2/4

TD 2300' Fsg.

2/11

K.G. 3140'. Arb. 3379'.

T.D. 3381'. Rng. 8".

No shows reported.

2/18

8" @ 3379'. T.D. 3386'.

2400' oil-14 hrs.

2000 acid.

2/26

Pot. 679 oil. No water.

Will retreat.

3/2

8" @ 3379'.

Arb. 3379'.

T.D. 3386'.

5000 acid.

Potential 1120 bbls.

COMPLETED

Barton KANSAS

Map No. 73 Sec. 8 Twp. 16 R. 13WWell No. 5 BitterT. C. Johnson Company


. Contractor

FIRST REPORT

C EL SW

 Ft. from N. Line1320 Ft. from S. Line330 Ft. from E. Line Ft. from W. Line

SECTION PLAT

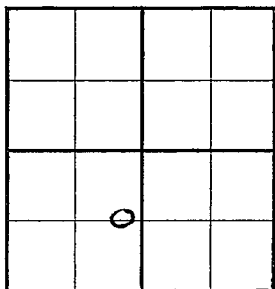Location Rig up

Drilling and Remarks:

Cellar

RECORD

Cased in., ft.Sand Gas Oil Total Depth

PRODUCTION

1st 24 hrs. Nat. 1st 24 hrs. after shot Gas Cu. Ft.Dry Hole Abandoned

Date

JAN 12. 1932 19H. D. Hatfield Scout

Barton KANSAS

Map No. _____ Sec. 8 Twp. 16 R. 13WWell No. 5 BitterT. C. Johnson

Company

Contractor

COMPLETED**C E L SW**

_____ Ft. from N. Line

1320 Ft. from S. Line330 Ft. from E. Line

_____ Ft. from W. Line

SECTION PLAT

Location _____

Rig up _____

Drilling and Remarks:

*5000 acid**POT 1120***RECORD**Cased 8 in. 3379 ft.~~Sand~~ *Arb* 3379

Gas _____

Oil _____

Total Depth 3386**PRODUCTION**

1st 24 hrs. Nat. _____

1st 24 hrs. after shot _____

Gas _____ Cu. Ft.

Dry Hole _____

Abandoned _____

Date

MAR 2 - 1938

19

H. D. Hatfield

Scout