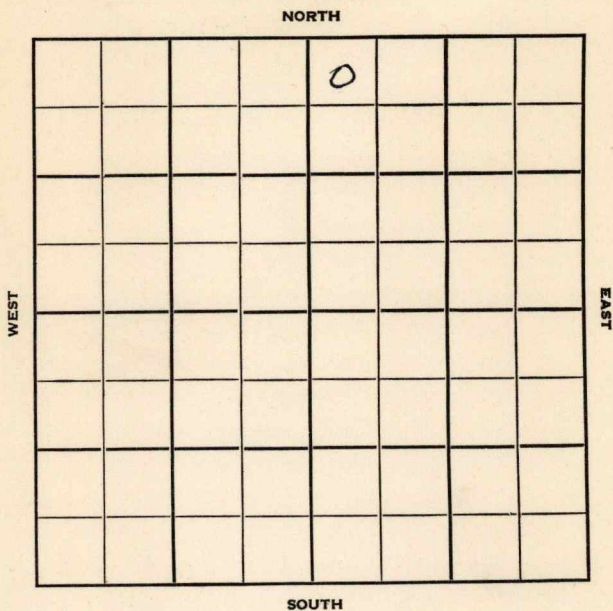


Section 9 Township 29 Range 6EWell No. #1 HansonCompany Dunn & Strait et al

KANSAS

Butler

Sec. 9 Twp. 29 R. 6 E

Well No. # 1 Hansen Farm

Dunn & Strait et al Company

Dunn & Strait Contractor


330 Ft. from N. Line

Ft. from S. Line

Ft. from E. Line

330 Ft. from W. Line

NW NW NE

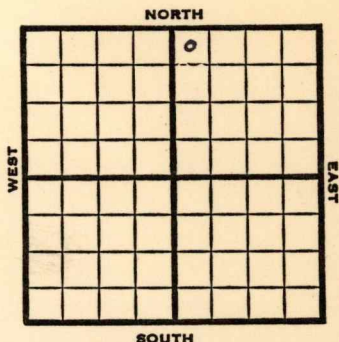

1951

Elev. 1426' REPORT

2/21 Cellar & pits

3/28 Oil Well TD 2824

Bart. 2795'

TD 2824

5" @ 2795'

Miss 2822'

Hydrofrac S/50 bopd

F/400 bo 16 hr.

Comp. 50 bopd

COMPLETED

County Butler State Kansas
 Sec. 9 (Blk. 29 (Sur. 6E Map No.
 (Twp.) (Rge.)
 Operator Dunn & Strait etal.
 Well No. 1 Farm Hansen
 Elev. _____ Location NW NW NE



330 Ft. From N Line NE
330 Ft. From W Line Quarter

1st. Report FEB 21 1951

Completion _____

Remarks _____

Dunn & Strait - Contr.

Spudding Date _____

Drig. Data _____

Cellar & pits

J. E. TYRA

County Butler State KansasSec. 9 (Blk.
Twp.) 29 (Sur.
Rge.) 6E Map No.Operator Dunn & Strait etal.Well No. 1 Farm HansenElev. 1426 Location NW NW NE

330 Ft. From N Line NE330 Ft. From W Line QuarterIst. ReportCompletion MAR 28 1951RemarksDunn & Strait - Contr.Spudding DateDrlg. Data Oil well TD 2824Bart. 2795 TD 2824 5" @ 2795Miss. 2822 Hydrofrac S/ 50 bopdF/ 400 bo 16 hr. Comp. 50 bopd

J. E. TYRA