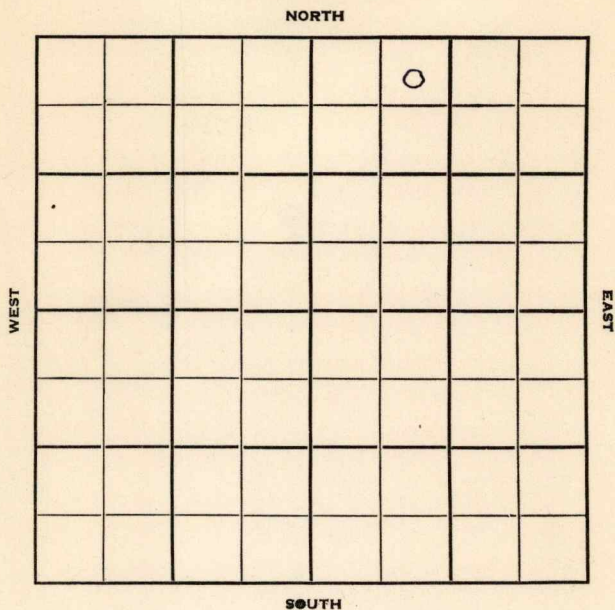


Section 9 Township 29 Range 6EWell No. #2 HansenCompany Dunne & Strait

Butler

KANSAS

Sec. 9 Twp. 29 R. 6E

Well No. #2 Hansen Farm

Dunne & Strait

Company

Dune & Strait
Semisch

Contractor

330

Ft. from N. Line


Ft. from S. Line

Ft. from E. Line

990

Ft. from W. Line

NE NW NE

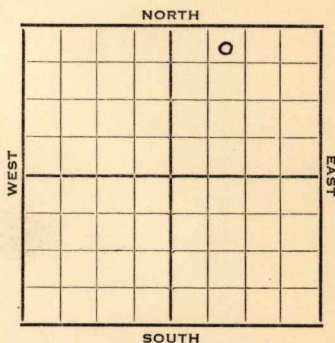

1952

Elev. 1429'

REPORT

1/16

Spud 1-12-52

8" @ 75'

Drlg. 900'

2/6

TD 2789 5" @ 2789

2/13

NR

3/26

Spud 1-12-52

Oil well TD 2823' 8" @ 75

Lans. 1770' KC 2164' B KC 2322'

Peru 2480' Bart. 2789' 5" @ 2789'

TD 2823' Hydro.

Comp. 50 BOPD

COMPLETED

County **Butler** State **Kansas**Sec. **9** (Blk.) **29** (Sur.) **6E** Map No.Operator **Dunne & Strait**Well No. **2** Farm **Hansen**Elev. Location **NE NW NE**

FIRST REPORT

330 Ft. From **N** Line **NE****990** Ft. From **W** Line Quarter1st. Report **JAN 16 1952**

Completion

Remarks

Dunne & Strait - Contr.Spudding Date **1-12-52**Drlg. Data **Semisch****8" @ 75 Drlg. 900****J. E. TYRA**

County Butler State Kansas
 Sec. 9 (Blk.) 29 (Sur.) 6E Map No.

Operator Dunne & Strait

Well No. 2 Farm Hansen

Elev. 1429 Location NE NW NE

330 Ft. From N Line NE

990 Ft. From W Line Quarter

1st. Report

Completion MAR 26 1952

Remarks Semisch Pool

Dunne & Strait - Contr.

Spudding Date 1-12-52

Drlg. Data Oil well TD 2823

8" @ 75 Lans. 1770 KC 2164

B KC 2322 Peru 2480 Bart. 2789

5" @ 2789 TD 2823 Hydro.

Comp. 50 bopd