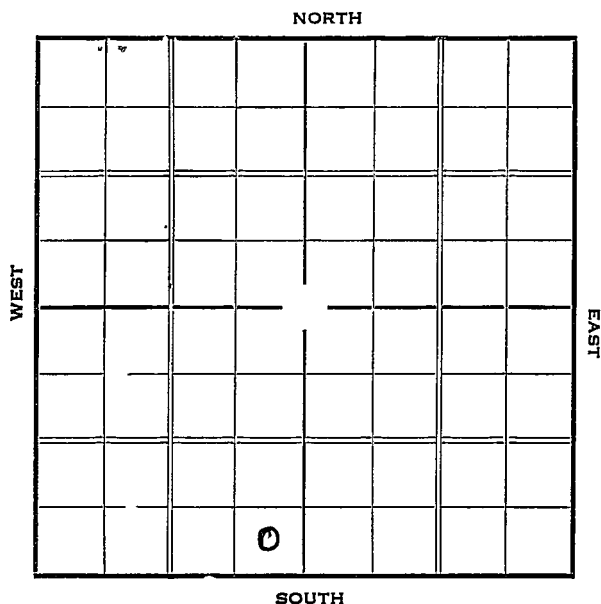


KANSAS Barton

Section 9 Township 16 Range 13-WWell Number 1 ~~Meier~~ Demc1Company Empire

KANSAS

Map No. _____ Sec. 9 Twp. 16 R. 13WWell No. 1 MeierEmpire Company

Contractor

SECTION PLAT

_____ Ft. from N. Line

330 Ft. from S. Line330 Ft. from E. Line

_____ Ft. from W. Line

FIRST REPORT

Location _____

Rig up _____

Drilling and Remarks:

ROG

RECORD

Cased _____ in., _____ ft.

Sand _____

Gas _____

Oil _____

Total Depth _____

PRODUCTION

1st 24 hrs. Nat. _____

1st 24 hrs. after shot _____

Gas _____ Cu. Ft.

Dry Hole _____

Abandoned _____

Date

FEB 10 1937₁₉

S. J. LEWIS Scout

Map No. 73 Sec. 9 Twp. 16 R. 19W.

Well No. 1 Item 6

Empire Company

Contractor

SECTION PLAT

_____ Ft. from N. Line

830 Ft. from S. Line

830 Ft. from E. Line

_____ Ft. from W. Line

CORRECTION

Location _____

Rig up _____

Drilling and Remarks:

*Reported as
No 1 Meier*

RECORD

Cased _____ in., _____ ft.

Sand _____

Gas _____

Oil _____

Total Depth _____

PRODUCTION

1st 24 hrs. Nat. _____

1st 24 hrs. after shot _____

Gas _____ Cu. Ft.

Dry Hole _____

Abandoned _____

Date

FEB 17 1937

19

S. I. LEVINS

Scout

KANSAS *Barton*Map No. *73* Sec. *9* Twp. *16* R. *13W*Well No. *1 Temel**Empire* Company

Contractor

SECTION PLAT

_____ Ft. from N. Line

330 Ft. from S. Line*330* Ft. from E. Line

_____ Ft. from W. Line

COMPLETED

Location _____

Rig up _____

Drilling and Remarks:

*Sil 3383**3000 acid**Potential**1114 oil 371 Water*

RECORD

Cased _____ in., _____ ft.

Sand _____

Gas _____

Oil _____

Total Depth *3389*

PRODUCTION

1st 24 hrs. Nat. _____

1st 24 hrs. after shot _____

Gas _____ Cu. Ft.

Dry Hole _____

Abandoned _____

Date

MAR 31 1937

19

S. J. LEWIS Scout