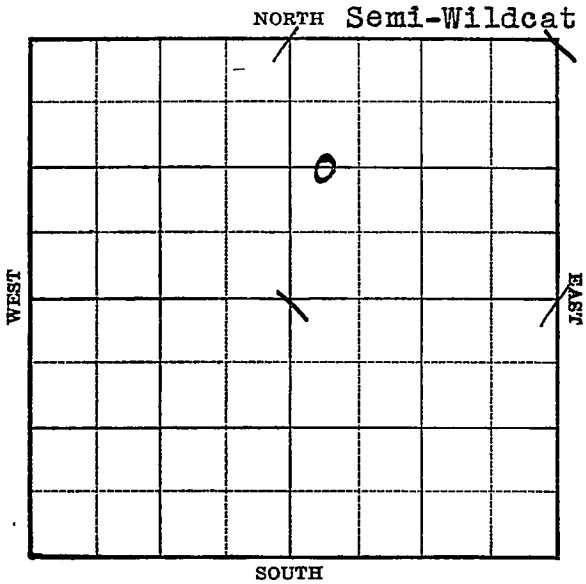


Section 9 Township 16 Range 13-WWell No. 1 DeutschCompany Harbar Drilling

Barton

KANSAS

Map No. 73 Sec. 9 Twp. 16 R. 13WWell No. 1 DeutschHarbar Drilling Company

Contractor


FIRST REPORT

C.S.O. Farm-out
SECTION PLAT

C W L NE

1320 Ft. from N. Line Ft. from S. Line Ft. from E. Line440 Ft. from W. Line

SEMI-WIT DC 4T

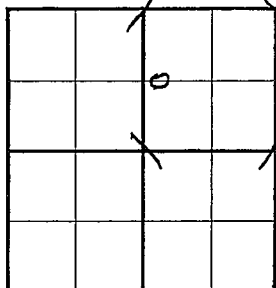Location Rig up Drilling and Remarks:
BRR

RECORD

Cased in., ft.Sand Gas Oil Total Depth

PRODUCTION

1st 24 hrs. Nat. 1st 24 hrs. after shot Gas Cu. Ft.Dry Hole Abandoned

Date

MAR 8 - 1939

19

H. D. Hatfield Scout

KANSAS

Barton

Map No. 73 Sec. 9 Twp. 16 R. 13WWell No. 1 DeutschHarbar Drlg. Company

Contractor

ABANDONED**C W L NE**1320 Ft. from N. Line Ft. from S. Line Ft. from E. Line440 Ft. from W. Line**SECTION PLAT**

		o	

SEMI-WILDCATLocation Rig up

Drilling and Remarks:

No oilD & A**RECORD**Cased in., ft.~~Sand~~ Arb 3388Gas Oil Total Depth 5420**PRODUCTION**1st 24 hrs. Nat. 1st 24 hrs. after shot Gas Cu. Ft.Dry Hole Abandoned

Date

H. D. Hatfield

MAR 29 1939 19 Scout