

2-28-18 E.Lind

**TYPE**



**AFFIDAVIT OF COMPLETION FORM**

**ACO-1 WELL HISTORY**

Compt. \_\_\_\_\_

**SIDE ONE**

Two (2) copies of this form shall be filed with the Kansas Corporation Commission, 200 Colorado Derby Building, Wichita, Kansas 67202, within thirty (30) days after the completion of a well, regardless of how the well was completed.

F Attach separate letter of request if the information is to be held confidential. If confidential, only file one copy. Information on Side One will be of public record and Side Two will then be held confidential.

Applications must be made on dual completion, commingling, salt water disposal, injection and temporarily abandoned wells.

C Attach one copy only wireline logs (i.e. electrical log, sonic log, gamma ray neutron log, etc.). (Rules 82-2-105 & 82-2-125) KCC# (316) 263-3238.

LICENSE # 6474 EXPIRATION DATE 7-84

OPERATOR Richard Oil Company API NO. 15-133-24,298

ADDRESS P.O. Box 814 1228 S. Steuben COUNTY Neosho

Chanute Kansas 66720 FIELD \_\_\_\_\_

\*\* CONTACT PERSON Mark R. Richard PROD. FORMATION Bartlesville  
PHONE (316) 431-2080 *KC-10 C*

PURCHASER Square Deal Oil Company LEASE Austin

ADDRESS Rt. 3 WELL NO. 8

Chanute Kansas 66720 WELL LOCATION \_\_\_\_\_

DRILLING CONTRACTOR L-K Drilling Inc. 1100 Ft. from South Line and

ADDRESS Route 2 Box 229 1025 Ft. from West Line of

Chanute Kansas 66720 the SW (Qtr.) SEC 2 TWP 28 RGE 18E.

PLUGGING CONTRACTOR \_\_\_\_\_

ADDRESS \_\_\_\_\_

TOTAL DEPTH 860' PBTD \_\_\_\_\_

SPUD DATE 3-12-84 DATE COMPLETED 3-27-84

ELEV: GR \_\_\_\_\_ DF \_\_\_\_\_ KB \_\_\_\_\_

DRILLED WITH (CABLE) - (ROTARY) (AIR) TOOLS.

DOCKET NO. OF DISPOSAL OR REPRESSURING WELL BEING USED TO DISPOSE OF WATER FROM THIS LEASE \_\_\_\_\_

Amount of surface pipe set and cemented 35' DV Tool Used? No

THIS AFFIDAVIT APPLIES TO: (Circle ONE) - (Oil) Gas, Shut-in Gas, Dry, Disposal, Injection, Temporarily Abandoned, OWWO. Other \_\_\_\_\_


ALL REQUIREMENTS OF THE STATUTES, RULES AND REGULATIONS PROMULGATED TO REGULATE THE OIL AND GAS INDUSTRY HAVE BEEN FULLY COMPLIED WITH.

**A F F I D A V I T**

Mark R. Richard, being of lawful age, hereby certifies that:

I am the Affiant, and I am familiar with the contents of the foregoing Affidavit. The statements and allegations contained therein are true and correct.

**WELL PLAT**

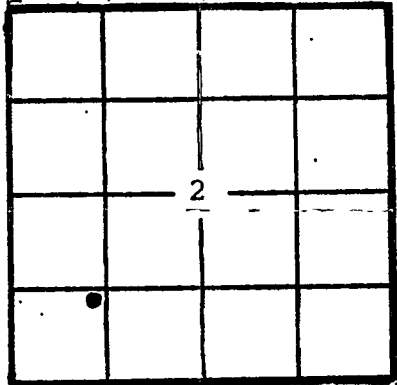

(Office Use Only)

KCC \_\_\_\_\_  
KGS \_\_\_\_\_  
SWD/REP \_\_\_\_\_  
PLG. \_\_\_\_\_

OPERATOR Richard Oil Co.

LEASE Austin

SEC. 2 TWP. 28 RGE. 18E

FILL IN WELL INFORMATION AS REQUIRED:

WELL NO. 8

Show all important zones of porosity and contents thereof; cored intervals, and all drill-stem tests, including depth interval tested, cushion used, time tool open, flowing and shut-in pressures, and recoveries.

SHOW GEOLOGICAL MARKERS, LOGS RUN, OR OTHER DESCRIPTIVE INFORMATION.

| FORMATION DESCRIPTION, CONTENTS, ETC.                                 | TOP | BOTTOM | NAME | DEPTH |
|---|-----|--------|------|-------|
| <input checked="" type="checkbox"/> Check if no Drill Stem Tests Run. |     |        |      |       |
| Soil  | 0   | 5      |      |       |
| Clay  | 5   | 22     |      |       |
| Gravel  | 22  | 33     |      |       |
| Ls  | 33  | 66     |      |       |
| Sh  | 66  | 72     |      |       |
| Ls  | 72  | 77     |      |       |
| Sdy Sh  | 77  | 104    |      |       |
| Ls s/ sh brks   | 104 | 213    |      |       |
| Ls  | 213 | 232    |      |       |
| Ls (sdy)  | 232 | 243    |      |       |
| Sdy Sh  | 243 | 277    |      |       |
| Broken Ls   | 277 | 292    |      |       |
| Sh  | 292 | 305    |      |       |
| Ls  | 305 | 312    |      |       |
| Sdy Sh  | 312 | 391    |      |       |
| Ls  | 391 | 394    |      |       |
| Coal  | 394 | 396    |      |       |
| Ls  | 396 | 435    |      |       |
| Sh  | 435 | 471    |      |       |
| Ls  | 471 | 492    |      |       |
| Sh  | 492 | 500    |      |       |
| Ls  | 500 | 505    |      |       |
| Sh  | 505 | 603    |      |       |
| Ls  | 603 | 605    |      |       |
| Sh  | 605 | 667    |      |       |
| Sd  | 667 | 672    |      |       |
| Sdy Sh  | 672 | 792    |      |       |
| Sd ( no oder)   | 792 | 800    |      |       |
| Oil Sd  | 800 | 802    |      |       |
| Core #1   | 802 | 815    |      |       |
| Broken Sd   | 815 | 819    |      |       |
| Core #2   | 819 | 839    |      |       |
| Sd ( shaly )  | 839 | 860    |      |       |

If additional space is needed use Page 2, Side 2

Report of all strings set — surface, intermediate, production, etc. **CASING RECORD** (New) or (Used)

| Purpose of string | Size hole drilled | Size casing set (in O.D.) | Weight lbs/ft. | Setting depth | Type cement | Socks | Type and percent additives |
|-------------------|-------------------|---------------------------|----------------|---------------|-------------|-------|----------------------------|
| Surface           | 9"                | 7"                        | New            | 30'           | Common      | 5     |                            |
| Production        | 5 1/4"            | 2-7/8"                    | New            | 850'          | Common      | 90    |                            |
|                   |                   |                           |                |               |             |       |                            |
|                   |                   |                           |                |               |             |       |                            |

**LINER RECORD**

**PERFORATION RECORD**

| Top, ft. | Bottom, ft. | Socks cement | Shots per ft. | Size & type | Depth interval |
|----------|-------------|--------------|---------------|-------------|----------------|
|          |             |              |               |             |                |

**TUBING RECORD**

| Size | Setting depth | Factor set at |
|------|---------------|---------------|
|      |               |               |