

KANSAS

Section 9 Township 29 Range 6EWell No. #2 WakefieldCompany E. Wakefield

Miscellaneous

NORTH

WEST

EAST

		○					

SOUTH

KANSAS

Butler



Sec. 9 Twp. 29 R. 6E

Well No. #2 Wakefield Farm

E. Wakefield Company

Miscellaneous


330' Ft. from N. Line

Ft. from S. Line

990' Ft. from E. Line

Ft. from W. Line

NW NENW

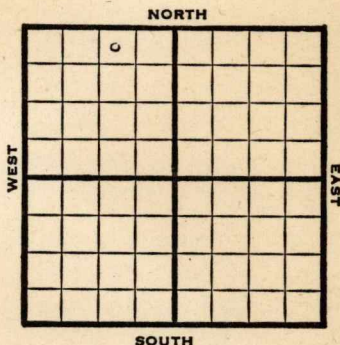

1948

Elev. 1415'

REPORT

2/25 Location

3/3 8" @ 90'
WOC

3/10 "

3/17 "

3/24 "

3/31 "

4/7 "

4/14 "

4/28 **Bart. 2730'**

TD 2814'

5" @ 2778'

RUST

5/5 "

5/12 "

5/19 **Bart 2730'**

5" @ 2778'

40 qts

Pump 45 oil & 10W Pot.

Gr. 40°

TD 2814'

COMPLETED

Map No. _____ Sec. 9 Twp. 29 R. 6E

Well No. 2 Wakefield

E. Wakefield Company

FIRST REPORT

Contractor

NW NE NW

SECTION PLAT

330 Ft. from N. Line

_____ Ft. from S. Line

990 Ft. from E. Line

_____ Ft. from W. Line

	0		

Butler County

Location X

Rig up _____

Drilling and Remarks:

RECORD

Cased _____ in., _____ ft.

Sand _____

Gas _____

Oil _____

Total Depth _____

PRODUCTION

1st 24 hrs. Nat. _____

1st 24 hrs. after shot _____

Gas _____ Cu. Ft.

Dry Hole _____

Abandoned _____

Date

FEB 25 1948

19

S. J. LEWIS Scout

Form 26—200 Bks.—1-48—Palace

Kansas

Map No. 11 Sec. 9 Twp. 29 R. 6EWell No. 2 WakefieldE. Wakefield Company**COMPLETE**

Contractor

NW NE NW

E. 1/4 15
SECTION PLAT330 Ft. from N. Line Ft. from S. Line990 Ft. from E. Line Ft. from W. Line

	4		

Butler County

Location Rig up

Drilling and Remarks:


RECORD

Cased in., ft.Sand Gas Oil Total Depth 2874

PRODUCTION

1st 24 hrs. Nat. 1st 24 hrs. after shot Gas Cu. Ft.Dry Hole Abandoned

Date

MAY 19 1948

19

S. J. LEWIS

Scout