

Sec. 9 Twp. 16 R. 13W

Well No. #2 Deutsch Farm

Branine & Holl Company


Susank

990 Ft. from N. Line

_____ Ft. from S. Line

_____ Ft. from E. Line

330 Ft. from W. Line

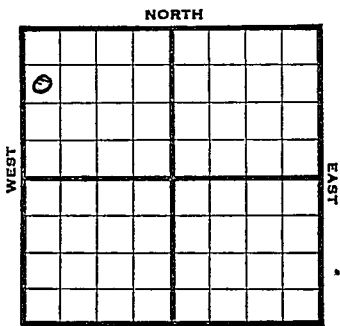

SW NW NW

Elmer 1937

SOUTH

1945

R E P O R T

- 1/24 Location
- 1/31 8" @ 365
Drlg. 3040'
- 2/7 Lens 3143
Arb 3483½
TD 3485
5" @ 3485 RUST
- 2/14 TD 3389 2600. oil 15 hrs
- 2/21 Arb. 3383½
5" @ 3385'
TD 3389
Pump 338 pot.
Grav. 40.9

COMPLETED

Pool Name Susank

Map No. 73 Sec. 9 Twp. 16 R. 13W

Well No. 2 Deutsch

Branine & Holl Company

FIRST REPORT Contractor

SW NW NW

SECTION PLAT

990 Ft. from N. Line

_____ Ft. from S. Line

_____ Ft. from E. Line

330 Ft. from W. Line

Barton

Location X

Rig up _____

Drilling and Remarks:

RECORD

Cased _____ in., _____ ft.

Sand _____

Gas _____

Oil _____

Total Depth _____

PRODUCTION

1st 24 hrs. Nat. _____

1st 24 hrs. after shot _____

Gas _____ Cu. Ft.

Dry Hole _____

Abandoned _____

Date

JAN 24 1945

19

S. I. LEWIS Scout

Pool Name SusankMap No. 78 Sec. 9 Twp. 16 R. 13WWell No. 2 DeutschBranine & Holl Company**COMPLETED**

Contractor

SW NW NW

SECTION FLAT

990

Ft. from N. Line

Ft. from S. Line

Ft. from E. Line

330

Ft. from W. Line

Barton

Location _____

Rig up _____

Drilling and Remarks:

Cor 3383 1/2
5" @ 3385.

Pump 3385 RT

40 7/8

RECORD

Cased _____ in., _____ ft.

Sand _____

Gas _____

Oil _____

Total Depth 3389

PRODUCTION

1st 24 hrs. Nat. _____

1st 24 hrs. after shot _____

Gas _____ Cu. Ft.

Dry Hole _____

Abandoned _____

Date

FEB 21 1945 19

S. J. LEWIS Scout