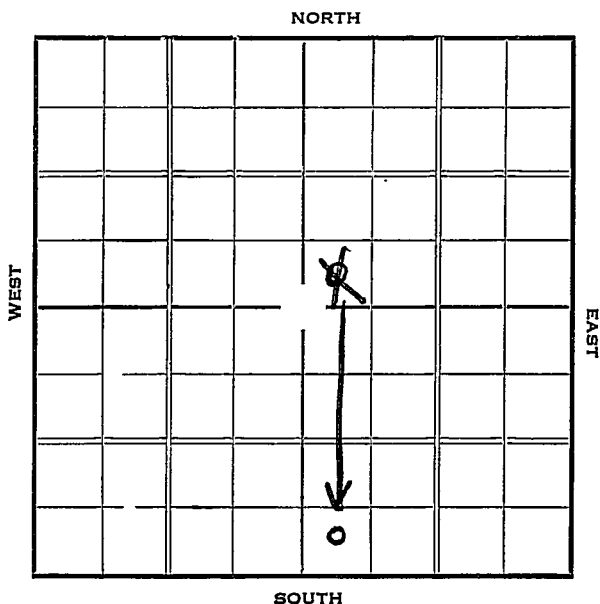
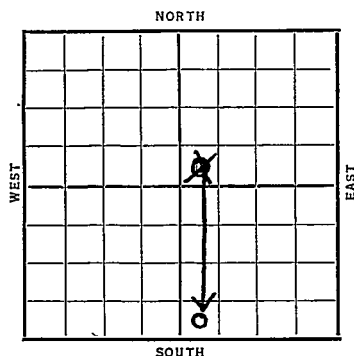


Section 9 Township 16 Range 13-WWell Number 1 KrameCompany Ohio Oil

Sec. 9 Twp. 16 R. 13WWell No. 1 Kramer FarmOhio Oil Company Ft. from N. Line330 Ft. from S. Line Ft. from E. Line330 Ft. from W. Line*Sh. 1911*Date
1937

REPORT

1/27	Rig
2/4	"
2/11	"
2/19	Rigging up/
2/26	10" @ 362' Drlg.
3/4	Drlg. 362'.
3/11	20" @ 248'. 445 fishing
3/18	" " " " "
3/25	Drlg. 638'.
4/2	Anhydrate 850'. Drlg. 1060'.
4/8	12" @ 870' Drlg. 1970'
4/16	Drlg. 2415'. 10" @ 2182'.
4/23	8" @ 2845'. Drlg. 2915'.
4/30	Drlg. 3330'.
5/7	Cong. 3372'. 6" @ 3376'.
	Sil. 3375'. T.D. 3380'.
	1000' oil $1\frac{1}{2}$ hrs.
	Treat with 1000 acid.
5/14	Potl 303. Reacidizing 1500 acid.

OVER

1937

5/19 6" @ 3376'.

Sil. 3375'.

T.D. 3379 $\frac{1}{2}$ '.

1000 acid.

Pumped 303 bbls.

1500 acid.

Potential 320 oil 190 water.

COMPLETED

KANSAS

Map No. 73 Sec. 9 Twp. 16 R. 13WWell No. 1 KramerOhio Oil Company

Contractor

SECTION PLAT

		0	

 Ft. from N. Line330 Ft. from S. Line Ft. from E. Line330 Ft. from W. Line

FIRST REPORT

Location Rig up

Drilling and Remarks:

Rig

RECORD

Cased in., ft.Sand Gas Oil Total Depth

PRODUCTION

1st 24 hrs. Nat. 1st 24 hrs. after shot Gas Cu. Ft.Dry Hole Abandoned

Date

JAN 27 1937 19

S. J. LEWIS

Scout

KANSASMap No. 73 Sec. 9 Twp. 16 R. 13WWell No. 1 KramerOhio Company

Contractor

SECTION PLAT

_____ Ft. from N. Line

330 Ft. from S. Line

_____ Ft. from E. Line

330 Ft. from W. Line**CORRECTION**

Location _____

Rig up _____

Drilling and Remarks:

Reported
OK. NE

RECORD

Cased _____ in., _____ ft.

Sand _____

Gas _____

Oil _____

Total Depth _____

PRODUCTION

1st 24 hrs. Nat. _____

1st 24 hrs. after shot _____

Gas _____ Cu. Ft.

Dry Hole _____

Abandoned _____

Date

FEB 3 1937

19

S. J. LEWIS Scout

Map No. 73 Sec. 9 Twp. 16 R. 13^WWell No. 1-KramerOhio

Company

Contractor

COMPLETED

SECTION PLAT

		0	

 Ft. from N. Line330 Ft. from S. Line Ft. from E. Line330 Ft. from W. LineLocation Rig up

Drilling and Remarks:

1000 Acid
Pumped 303

1500 Acid

Pot 320 oil

190 water

RECORD

Cased 6 in., 3376 ft.Sand Si/ 3375Gas Oil Total Depth 3379 1/2

PRODUCTION

1st 24 hrs. Nat. 1st 24 hrs. after shot Gas Cu. Ft.Dry Hole Abandoned

Date

MAY 19 1937 19

H. D. Hatfield

Scout