

KANSAS


Butler

Section 9 Township 29 Range 6E

Well No. #1 Wakefield

Company E. Wakefield

Miscellaneous

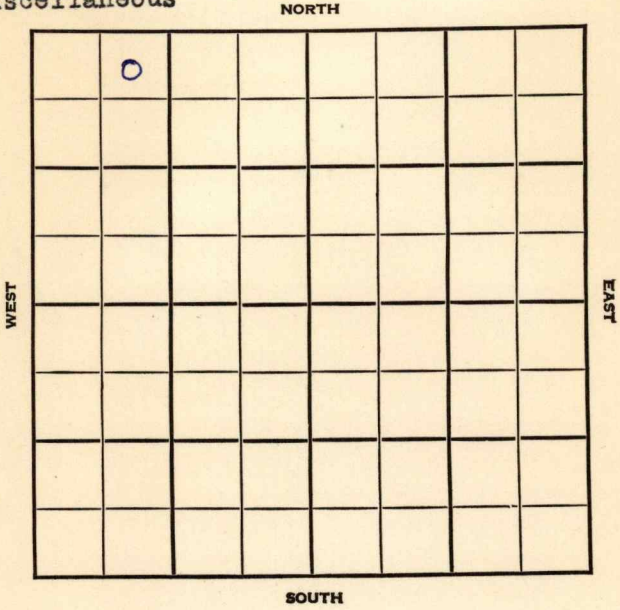

Butler

Sec. 9 Twp. 29 R. 6E

Well No. #1 Wakefield Farm
E, Wakefield Company

Miscellaneous


330' Ft. from N. Line

 Ft. from S. Line

 Ft. from E. Line

990' Ft. from W. Line

NE NW NW

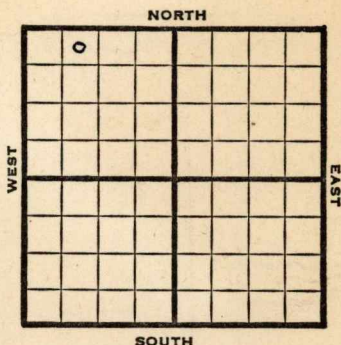

1948 Elev. 1405' REPORT

2/11	Spud
2/18	SD
2/25	8" @ 136'
	WOC
3/3	"
3/10	"
3/17	"
3/24	"
3/31	"
4/7	Drilg. 1345'
4/14	TD 2810'
	5" @ 2758'
4/21	Bart 2730'
	5" @ 2708'
	TD 2810'
	1000' oil 8 hrs.
4/28	TD 2814'
5/5	Bart 2730'
	5" @ 2758'
	Pump 20 oil & 30W Pot.
	Gr. 390
	TD 2814'

COMPLETED

Map No. 11 Sec. 9 Twp. 29 R. 6E

Well No. 1 Wakefield

E. Wakefield Company

COMPLETE Contractor

NE NW NW

E. 11405
SECTION PLAT

330 Ft. from N. Line

_____ Ft. from S. Line

_____ Ft. from E. Line

990 Ft. from W. Line

✓			

Butler County

Location _____

Rig up _____

Drilling and Remarks:

Bar 82750

5' @ 2758.

RECORD

Cased _____ in., _____ ft.

Sand _____

Gas _____

Oil ☒

Total Depth 2874

PRODUCTION

1st 24 hrs. Nat. _____

1st 24 hrs. after shot _____

Gas _____ Cu. Ft.

Dry Hole _____

Abandoned _____

Date

MAY 5 1948 19 S. J. LEWIS Scout

Map No. _____ Sec. 9 Twp. 29 R. 6E

Well No. 1 Wakefield

E. Wakefield Company

FIRST REPORT Contractor

NE NW NW


SECTION PLAT

330 Ft. from N. Line

_____ Ft. from S. Line

_____ Ft. from E. Line

990 Ft. from W. Line

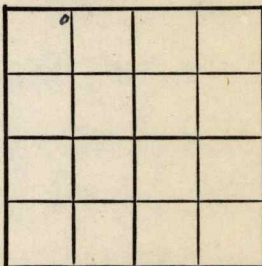

Butler County

Location _____

Rig up _____

Drilling and Remarks:

Spud

RECORD

Cased _____ in., _____ ft.

Sand _____

Gas _____

Oil _____

Total Depth _____

PRODUCTION

1st 24 hrs. Nat. _____

1st 24 hrs. after shot _____

Gas _____ Cu. Ft.

Dry Hole _____

Abandoned _____

Date

FEB 11 1948

19

S. J. LEWIS

Scout