


Section 9 Township 16 Range 13-W

Well Number 2 - Kramer

Company Ohio

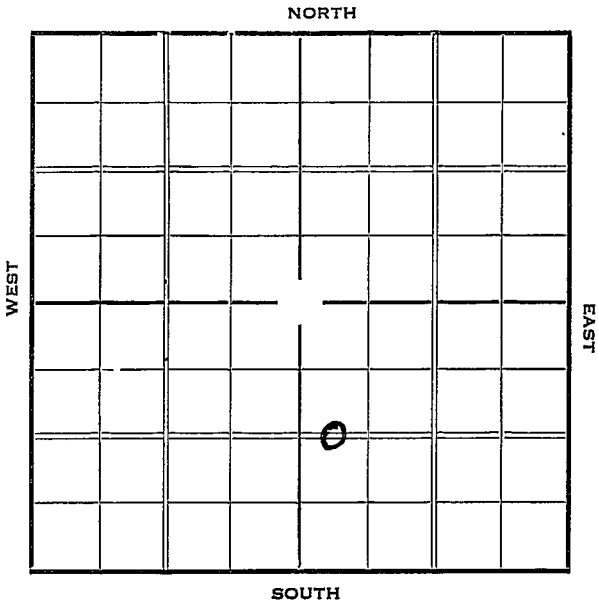

Sec. 9 Twp. 16 R. 13-W

Well No. #2 Kramer Farm

Ohio Company


_____ Ft. from N. Line

1320 Ft. from S. Line

_____ Ft. from E. Line

330 Ft. from W. Line

Elev. 1928

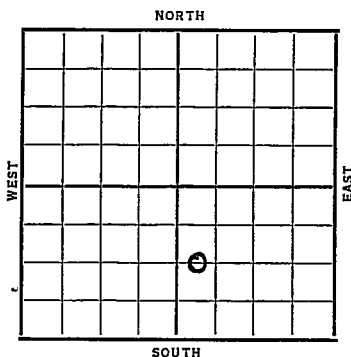

Date	REPORT
1937	
5/19	Location
5/28	C. Rig.
6/4	Rigging up
6/11	20" @ 289'. Drlg. 470'.
6/19	15" @ 493'. T.D. 720' SD.
6/25	Anhy 870'. 12" @ 892'. j
	Drlg. 1250'.
7/2	Drlg. 2225'.
7/9	Drlg. 2393'.
7/16	10" @ 2200'. 8" @ 2802'.
	Drlg. 2840'.
7/23	Fsg. 3287'.
7/30	" "
8/6	" "
8/13	" "
8/20	" "
8/28	" "
9/3	" "
9/10	6" @ 3303'. Drlg. 3360'.
9/17	Sil. & 5" @ 3386'.
	T.D. 3393'. 1000' oil in 3½
	hours.

OVER

1937

9/24 1000 acid. No test.

9/29 5" @ 3386'.

Sil. 3386'.

T.D. 3393'.

1000 acid.

Pot. 1013 bbls.

COMPLETED.

Barton KANSASMap No. 73 Sec. 9 Twp. 16 R. 13 ^WWell No. 2 - KumerOhio

Company

Contractor

FIRST REPORT

SECTION PLAT

_____ Ft. from N. Line

1320 Ft. from S. Line

_____ Ft. from E. Line

330 Ft. from W. LineLocation ✓

Rig up _____

Drilling and Remarks:

RECORD

Cased _____ in., _____ ft.

Sand _____

Gas _____

Oil _____

Total Depth _____

PRODUCTION

1st 24 hrs. Nat. _____

1st 24 hrs. after shot _____

Gas _____ Cu. Ft.

Dry Hole _____

Abandoned _____

Date

MAY 19 1937

H. D. Hatfield

19

Scout

Barton **KANSAS**Map No. _____ Sec. 9 Twp. 16 R. 13WWell No. 2 - KramerOhio

Company _____

Contractor _____

C WL SE $\frac{1}{4}$

SECTION PLAT

		0	

_____ Ft. from N. Line

1320 Ft. from S. Line

_____ Ft. from E. Line

330 Ft. from W. Line

Location _____

Rig up _____

Drilling and Remarks:

*1000 acid**Pat - 1013'*

RECORD

Cased 5 in., 3386 ft.~~Sand~~ 511 3386

Gas _____

Oil _____

Total Depth 3393

PRODUCTION

1st 24 hrs. Nat. _____

1st 24 hrs. after shot _____

Gas _____ Cu. Ft.

Dry Hole _____

Abandoned _____

Date

SEP 29 1937 19

H. D. Hatfield

Scout