


Section 9 Township 29 Range 6E

Well No. 3 Wakefield

Company Wakefield

Misc.
NORTH

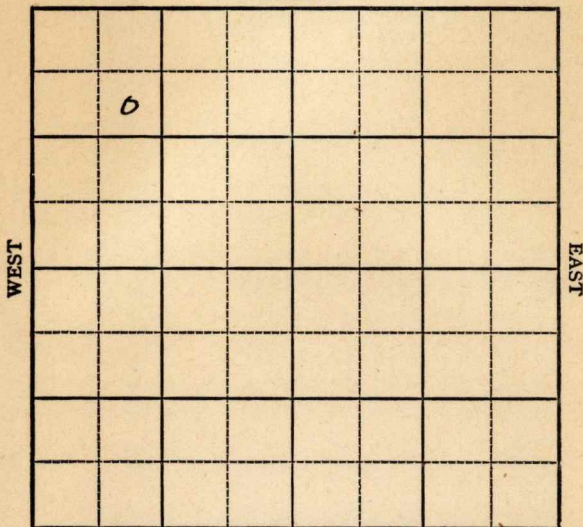

SOUTH

KANSAS

Butler



Sec. 9 Twp. 29 R. 6E

Well No. #3 Wakefield Farm

Wakefield

Company

Miscellaneous


990' Ft. from N. Line

_____ Ft. from S. Line

_____ Ft. from E. Line

990' Ft. from W. Line

SW NW NW

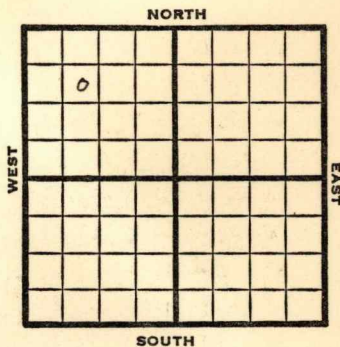

1948

Elev. 1413' REPORT

11/23

8" @ 86'
Drlg. 2730'

11/30

Bart 2791'
TD 2797'
5" @ 2791'

12/6

Swb 4 bbls oil & 4 W - PH

12/14

Miss 2827'
TD 2828'

12/22

Bart 2791'
Miss 2827'
5" @ 2791'
Pump 25 oil & 28 W Pot.
Gr. 38°
TD 2818'

COMPLETED

Map No. _____ Sec. 9 Twp. 29 R. 6E

Well No. 3 Wakefield

Wakefield Company

FIRST REPORT Contractor

SE NW NW

SECTION PLAT

990 Ft. from N. Line

_____ Ft. from S. Line

_____ Ft. from E. Line

990 Ft. from W. Line

Butler County

RECORD

Location _____

Cased _____ in., _____ ft.

Rig up _____

Sand _____

Drilling and Remarks:

Gas _____

Oil _____

Total Depth _____

8" @ 86

drlg. 2730

PRODUCTION

1st 24 hrs. Nat. _____

1st 24 hrs. after shot _____

Gas _____ Cu. Ft.

Dry Hole _____

Abandoned _____

Date

NOV 23 1948 19

S. J. LEWIS

Scout

Map No. 11 Sec. 9 Twp. 29 R. 6E

Well No. 3 Wakefield

Wakefield Company

COMPLETE Contractor

SE NW NW

E. 1. 1413
SECTION PLAT

990 Ft. from N. Line

_____ Ft. from S. Line

_____ Ft. from E. Line

990 Ft. from W. Line

0			

Butler County

RECORD

Location _____

Cased _____ in., _____ ft.

Rig up _____

Sand _____

Drilling and Remarks:

Gas _____

Oil

Total Depth 2515'

PRODUCTION

1st 24 hrs. Nat. _____

1st 24 hrs. after shot _____

Gas _____ Cu. Ft.

Dry Hole _____

Abandoned _____

Bas 72791
Misc 2727
5" @ 2791
Prod 25 oil + 25W
BT
85' @

Date

DEC 22 1948

19

S. J. LEWIS

Scout