

KANSAS

Butler

Section 9 Township 29 Range 6E

Well No. 4 Wakefield

Company Wakefield

Misc.

NORTH

	0						

WEST

EAST

SOUTH

KANSAS

Butler

Sec. 9 Twp. 29 R. 6E ✓

Well No. #4 Wakefield Farm

Wakefield Company

Miscellaneous


330' Ft. from N. Line

_____ Ft. from S. Line

_____ Ft. from E. Line

330' Ft. from W. Line

NW/c

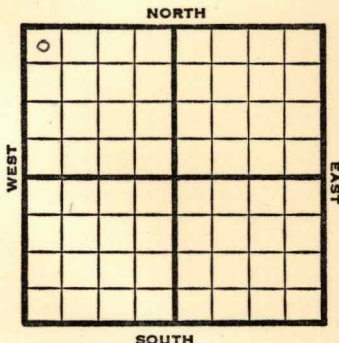

1948 **Elev. 1402'** REPORT

11/23 8" @ 105'

11/30 Drlg. 1804'

12/6 **Bart 2792'**

Miss 2821'

TD 2824'

5" @ 2792'

12/14 "

12/22 "

12/29 40 qts 2801-2820

CO

1949

1/5 **Bart 2792'**

Miss 2821'

5" @ 2792'

40 qts 2801-20

Pump 15 oil & 4 W Pot.

Gr. 38°

TD 2824'

COMPLETED

Map No. _____ Sec. 9 Twp. 29 R. 6E

Well No. 4 Wakefield

Wakefield Company

FIRST REPORT Contractor

NW/C

SECTION PLAT

330 Ft. from N. Line

_____ Ft. from S. Line

_____ Ft. from E. Line

330 Ft. from W. Line

0			

Butler County

RECORD

Location _____

Cased _____ in., _____ ft.

Rig up _____

Sand _____

Drilling and Remarks:

Gas _____

Oil _____

8" @ 105

Total Depth _____

PRODUCTION

1st 24 hrs. Nat. _____

1st 24 hrs. after shot _____

Gas _____ Cu. Ft.

Dry Hole _____

Abandoned _____

Date

NOV 23 1948 19

S. J. LEWIS Scout

Kansas

Map No. 11 Sec. 9 Twp. 29 R. 6E

Well No. 4 Wakefield

Wakefield

Company

COMPLETE

Contractor

NW/C

E. 1402

SECTION PLAT

0			

330 Ft. from N. Line

_____ Ft. from S. Line

_____ Ft. from E. Line

330 Ft. from W. Line

Butler County

Location _____

Rig up _____

Drilling and Remarks:

Bar 2792
Wire 2821
5" @ 2792
Log to 2501-20
Prod 15 oil + 4 W
Bot 28° se

RECORD

Cased _____ in., _____ ft.

Sand _____

Gas _____

Oil _____

Total Depth 2824

PRODUCTION

1st 24 hrs. Nat. _____

1st 24 hrs. after shot _____

Gas _____ Cu. Ft.

Dry Hole _____

Abandoned _____

Date

JAN 5 1949 19

S. J. LEWIS

Scout