

Section 9 Township 29 Range 6EWell No. #2 WakefieldCompany Earl Wakefield

NORTH

			0				

WEST

EAST

SOUTH

Butler

KANSAS

Sec. 9 Twp. 29 R. 6E

Well No. #7
#6 Wakefield Farm

Earl Wakefield Company

Contractor

Semeish Pool


330' Ft. from N. Line

_____ Ft. from S. Line

330' Ft. from E. Line

_____ Ft. from W. Line

NE NE NW

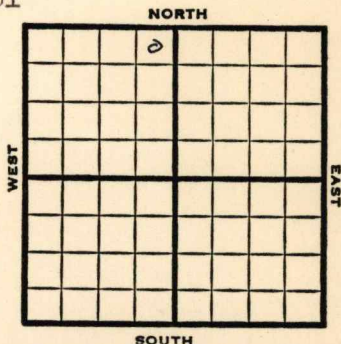

1950

Elev 1428'

REPORT

12/13

Location

1951

1/24

8" @ 95

KC 2155

SO 2155-68

Peru 2504-20

Bart 2745

Sand 2775

SO 2810-15

5" @ 2810

TD 2832

Miss 2831

S/13 bopd

Hydrafrac

Comp 50 bopd

Completed

COMPLETED

County **Butler** State **Kansas**

Sec. **9** (Blk. Twp.) **29** (Sur. Rge.) **6E** Map No.

Operator **Earl Wakefield**

Well No. **6** Farm **Wakefield**

Elev. Location **NE NE NW**

330 Ft. From **Nq** Line **NW**

330 Ft. From **E** Line Quarter

1st. Report **DEC 13 1950**

Completion

Remarks

Spudding Date

Drlg. Data **Semeish Pool**

Location

J. E. TYRA

Kansas

Map No. _____ Sec. 9 Twp. 29 R. 6EWell No. 7 WakefieldEarl Wakefield

Company

CORRECTION

Contractor

NE NE NW

SECTION PLAT

330 Ft. from N. Line

_____ Ft. from S. Line

330 Ft. from E. Line

_____ Ft. from W. Line

		0	

Butler County

Location _____

Rig up _____

Drilling and Remarks:

Reported

#6 Wakefield

RECORD

Cased _____ in., _____ ft.

Sand _____

Gas _____

Oil _____

Total Depth _____

PRODUCTION

1st 24 hrs. Nat. _____

1st 24 hrs. after shot _____

Gas _____ Cu. Ft.

Dry Hole _____

Abandoned _____

Date

JAN 3 1951 19

J. E. TYRA

Scout

County Butler State Kansas
 Sec. 9 (Blk. 29 (Sur. 6E Map No.)
 Operator Earl Wakefield
 Well No. 7 Farm Wakefield
 Elev. 1428 Location NE NE NW

330 Ft. From N Line NW
330 Ft. From E Line Quarter

Ist. Report

Completion JAN 24 1951

Remarks

Spudding Date

Drlg. Data Oil well TD 2832
8" @ 95 KC 2155 SO 2155-68 Peru 2504-
20 Bart. 2745 Sand 2775 SO 2810-15
5" @ 2810 TD 2832 Miss. 2831
S/ 13 bopd Hydrofrac Comp. 50 bopd

J. E. TYRA