


Barton **KANSAS**

Section 10 Township 16 Range 13W

Well No. #1 Ehrlich

Company Elreco Ref.

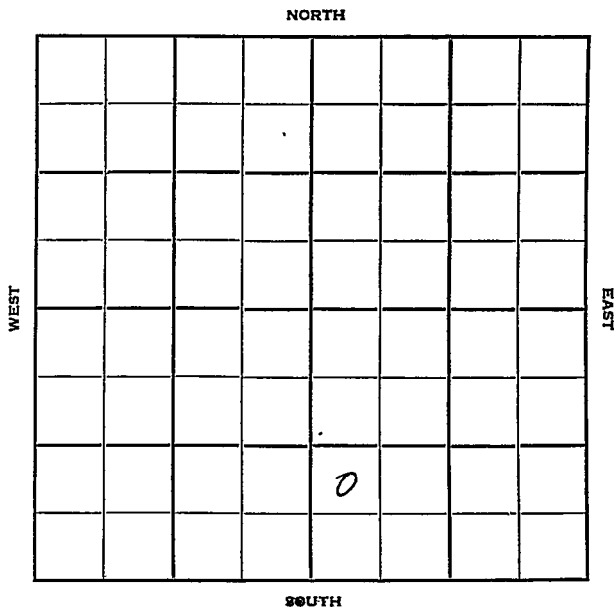

Barton

KANSAS

Sec. 10 Twp. 16 R. 13 W

Well No. # 1 Ehrlich Farm

Elreco Ref. Company

Anschutz Drlg. Contractor


_____ Ft. from N. Line

990 Ft. from S. Line

_____ Ft. from E. Line

330 Ft. from W. Line

NW SW SE

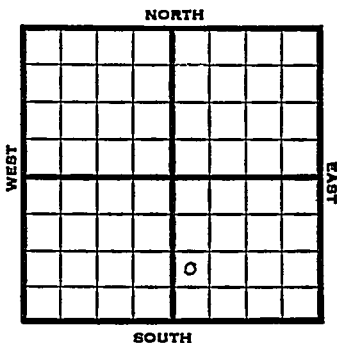

1951

Elev. 1890'

REPORT

6/6

R U R

6/20

Spud 6-5-51

D&A TD 3385

8" @ 300

Anhy 845 Heeb. 3022

Br Lime 3105 Lans. 3114

Arb. 3358 TD 3385

D&A

ABANDONED


County Barton State Kansas

Sec. 10 (Blk. 16) (Sur. 13W) Map No.

Operator Elreco Ref.

Well No. 1 Farm Ehrlich

Elev. 1890 Location NW SW SE

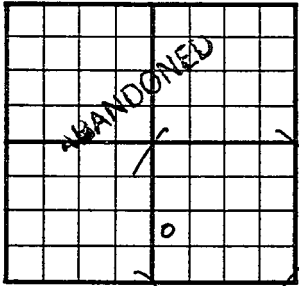

990 Ft. From S Line SE

330 Ft. From W Line Quarter

1st. Report

Completion JUN 20 1951

Remarks

Anschutz Drlg. - Contr.

Spudding Date 6-5-61

Drlg. Data D & A TD 3385

8" @ 300 Anhy 845 Heeb. 3022

Br. lime 3105 Lans. 3114 Arb. 3358

TD 3385 D & A