
Form 51-5M-12-36 Com'l

KANSAS Barton

Section 12 Township 16 Range 13-W

Well Number 1 Fredrick

Company Geo. Hinkle & Phillips Pet ~~Wilson & Union Oil~~

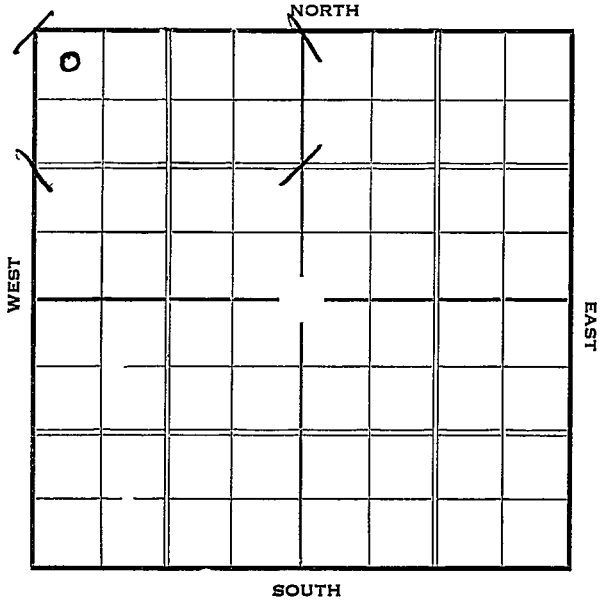

Special

Form 252-A—5M—7-36—Palace KANSAS Barton

Sec. 12 Twp. 16 R. 13-W

Well No. #1 Fredrick Farm


~~Wixson & Hyton Oil~~ Company
Geo. Hinkle & Phillips Pet

330 Ft. from N. Line

Ft. from S. Line

Ft. from E. Line

330 Ft. from W. Line

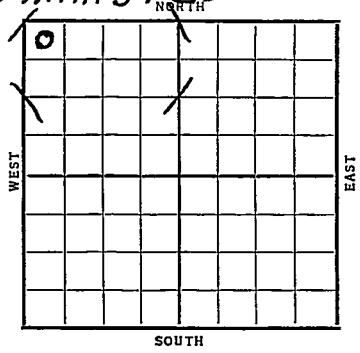

Special

Date 1937	REPORT
2/10	Location
2/19	Cellar
2/26	ROG
3/4	"
3/11	Rigging up.
3/18	Spud 400'.
3/25	12" @ 655'. Drlg. 865'.
4/2	Anhydrate 862'. Drlg. 1665'
4/8	10" @ 2163' Drlg. 2295'
4/16	8" @ 2780'. Drlg. 2805'.
4/23	K C Lime 3110'. Drlg. 3340'.
4/28	Sil. 3373'.
	T.D. 3391'. H.F.W.
	ABANDONED

Form 26—1M Bks.—2-29 KANSAS

Map No. _____ Sec. 12 Twp. 16 R. 13W

Well No. 1 Freelick

Wilson & Union Oil Company

_____ Contractor

Special

330 Ft. from N. Line


_____ Ft. from S. Line

_____ Ft. from E. Line

330 Ft. from W. Line

FIRST REPORT

SECTION PLAT

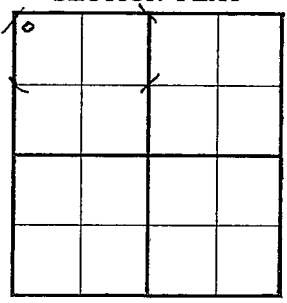

Location V

Rig up _____

Drilling and Remarks:

RECORD

Cased _____ in., _____ ft.

Sand _____

Gas _____

Oil _____

Total Depth _____

PRODUCTION

1st 24 hrs. Nat. _____

1st 24 hrs. after shot _____

Gas _____ Cu. Ft.

Dry Hole _____

Abandoned _____

Date

FEB 10 1937 19 _____ S. J. LEWIS Scout

Form 26—1M Blks.—2-29 KANSAS

Map No. 73 Sec. 12 Twp. 16 R. 13W

Well No. 1 Frederick

Geo Heinkle & Phillips Ed Company

Contractor

330 Ft. from N. Line


Ft. from S. Line

Ft. from E. Line

330 Ft. from W. Line

CORRECTION

SECTION PLAT

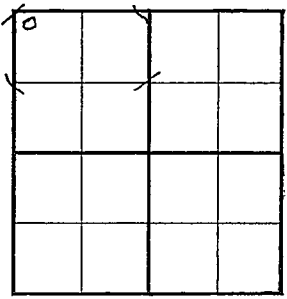

Location

Rig up

Drilling and Remarks:

Reported as.
Swison & Union
Oil

RECORD

Cased in., ft.

Sand

Gas

Oil

Total Depth

PRODUCTION

1st 24 hrs. Nat.

1st 24 hrs. after shot

Gas Cu. Ft.

Dry Hole

Abandoned

Date

FEB 17 1937 19

S. J LEWIS Scout

Form 26—1M Bks.—2-29 Barton KANSAS

Map No. _____ Sec. 12 Twp. 16 R. 13 W

Well No. 1 - Frederick

Geo. Hinkle & Phillips Company

_____ Contractor

ABANDONED


330 Ft. from N. Line

_____ Ft. from S. Line

_____ Ft. from E. Line

330 Ft. from W. Line

SECTION PLAT

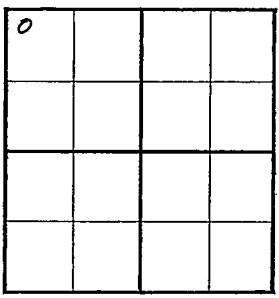

Location _____

Rig up _____

Drilling and Remarks:

H, F, W.

D & A

RECORD

Cased _____ in., _____ ft.

~~Sand~~ Sil - 3373

Gas _____

Oil _____

Total Depth 3391

PRODUCTION

1st 24 hrs. Nat. _____

1st 24 hrs. after shot _____

Gas _____ Cu. Ft.

Dry Hole _____

Abandoned _____

Date APR 28 1937

_____ 19 _____ H. D. Hatfield Scout