


KANSAS

Butler

Section 9 Township 29 Range 6-E

Well No. #6 Wakefield

Company Wakefield

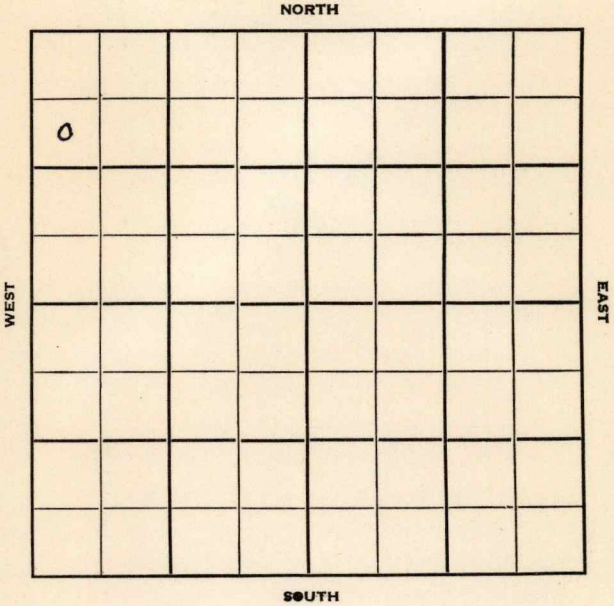

Butler

KANSAS

Sec. 9 Twp. 29 R. 6E

Well No. #6 Wakefield Farm

Wakefield Company

Contractor


990' Ft. from N. Line

Ft. from S. Line

Ft. from E. Line

330' Ft. from W. Line

SW NW NW

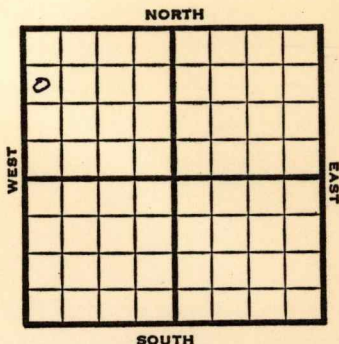

1951

Elev. 1408

REPORT

1/3

8" @ 90'

Drlg. 1385'

2/28

Oil Well TD 2798

8" @ 90' KC 2159

Bart 2758-92 TD 2798

5" @ 2789 S/7 bopd Hydrafrac

Comp. 50 bopd

COMPLETED

County **Butler** State **Kansas**Sec. **9** (Blk.) **29** (Sur.) **6E** Map No.Operator **Wakefield**Well No. **6** Farm **Wakefield**Elev. Location **SW NW NW**

0

FIRST REPORT

~~990~~ Ft. From **N** Line **NW**~~338~~
~~990~~ Ft. From **W** Line Quarter1st. Report **JAN 3 1951**

Completion

Remarks

Spudding Date

Drlg. Data

8" @ 90 drlg. 1385

J. E. TYRA

County Butler State KansasSec. 9 (Blk.
Twp.) 29 (Sur.
Rge.) 6E Map No. _____Operator Earl WakefieldWell No. 6 Farm WakefieldElev. 1408 Location SW NW NW

0							

990 Ft. From N Line NW330 Ft. From W Line Quarter

1st. Report _____

Completion FEB 28 1951

Remarks _____

Spudding Date _____

Drlg. Data Oil well TD 27988" @ 90 KC 2159 Bart. 2758-92 TD 27985" @ 2789 S/ 7 bopd HydrofracComp. 50 bopd

J. E. TYRA