


Barton

KANSAS

SECTION 12 TOWNSHIP 16 RANGE 13W

WELL NO. #1 Allen

COMPANY Phillips Petroleum

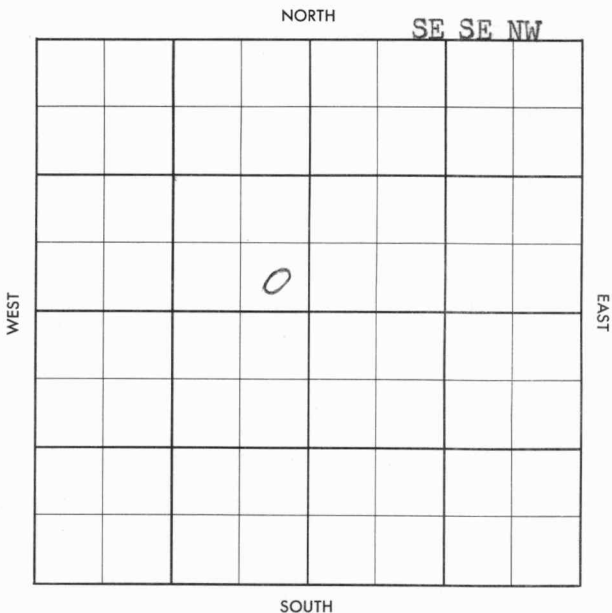

County Barton Elev. _____
 Sec. 12 Twp. 16 Rge. 13W
 Company Phillips Petroleum
 Farm Name Allen No. 1

TOPS	DEPTH	LOG	DATUM	Loc. in Sec.
Anh.				SE SE NW
T.P.				
H.				
Tr.				
Dg.				
B.L.				
L.				Geol. _____
K.C.				Contr. _____
B.K.C.				
Ce.				
C.				
M.				
M.				Pool _____
K.				
Mz.				
Me.				
V.				
S.				
S.				
A				
R.				
Pe.				
G.				
T.D.				

FIRST REPORT
 AUG 14 57

Date Comm. _____
 Location _____

~~13~~

Co.
 Lse.
 No.
 Sec.
 T.
 R.

TITE

FORM 513 SUNRAY

County Barton Elev. 1912
 Sec. 12 Twp. 16 Rge. 13W
 Company Phillips Petroleum
 Farm Name Allen No. 1

TOPS	DEPTH	LOG	DATUM	Loc. in Sec.
Anh.				SE SE NW
TP.				
H.	3026			
Tr.	3096			
Dg.				
BL.	3111			
L.	3122			
K.C.				Geol.
B.K.C.				Contr. <u>Stevling</u>
Ce.				
C.				
M.				
M.				Pool
K.				
Mz.				
Mo.				
V.				COMPLETE
S.				
S.				
A	3372			
R.				
PE.				
G.				
I.D.	3386 3375			SEP 25 '57

Date Comm. 8-13-57

Location AUG 21 '57 95/8 @ 429/3105X P 2811

AUG 28 '57 Pipe set SEP 4 '57 SEP 11 '57

SEP 18 '57 P SEP 25 '57 7" 3374

CO 3386 TV 1000' oil &

125 BO now 7 hrs POP

P 238 BOPd now attached