


Section 9 Township 29 Range 6E

Well No. #13 Wakefield

Company E. F. Wakefield

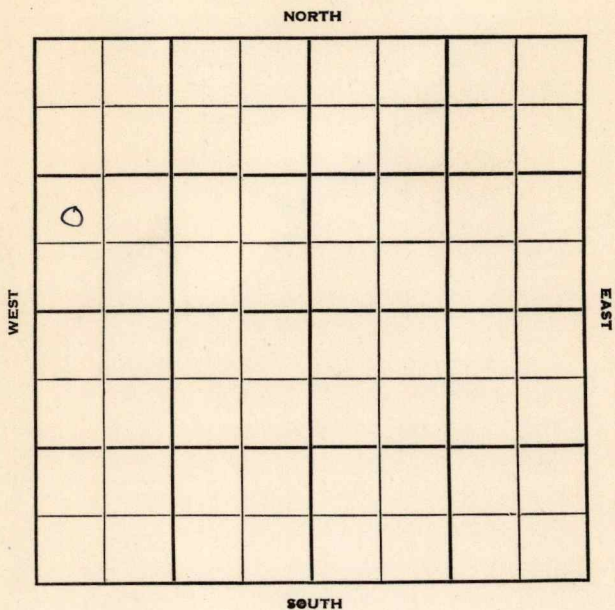

Butler

KANSAS

Sec. 9 Twp. 29 R. 6E

Well No. #13 Wakefield Farm

E. F. Wakefield Company

Contractor


Ft. from N. Line

990' Ft. from S. Line

Ft. from E. Line

330' Ft. from W. Line

NW SW NW

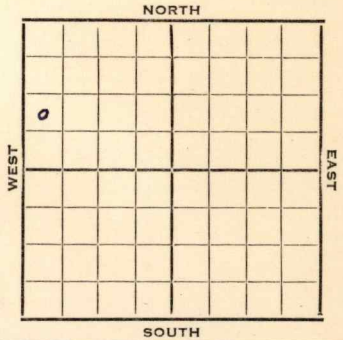

1952

Elev. 1416' REPORT

4/9

Location

4/28

Oil Well TD 2829

8" @ 125 Stal 1629 Bart 2783

Sand 2813-15 5" @ 2813 TD 2829

Hydra Comp. 25 bopd

COMPLETED



