

Section 12 Township 16 Range 13W

Well No. 1 Phillips

Company Derby Drlg. et al

A hand-drawn map of a square area with a grid. The grid is 8 squares wide and 8 squares high. The top edge is labeled "NORTH", the bottom edge "SOUTH", the left edge "WEST", and the right edge "EAST". The name "Susank" is written in the top-left corner. A small circle is drawn in the center of the grid, at the intersection of the 4th vertical line from the left and the 4th horizontal line from the top.

KANSAS

Barton ✓

Sec. 12 Twp. 16 R. 13-W

Well No. #1 Phillips Farm

Derby Drlg. etal Company

Susank Pool


330 Ft. from N. Line

Ft. from S. Line

330 Ft. from E. Line

Ft. from W. Line

NE SW

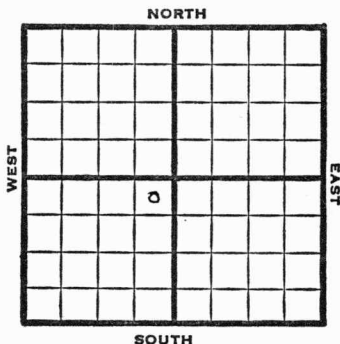

1947

Elev. 1913 REPORT

4/23

R U R

4/29

8" @ 229'
Drlg 2634'

5/7

Arb 3366
TD 3420'

ABANDONED

Map No. K73 Sec. 12 Twp. 16 R. 13W

Well No. 1 Phillips

Derby Drlg. etal. Company

FIRST REPORT Contractor

NE SW


SECTION PLAT

330 Ft. from N. Line

 Ft. from S. Line

330 Ft. from E. Line

 Ft. from W. Line

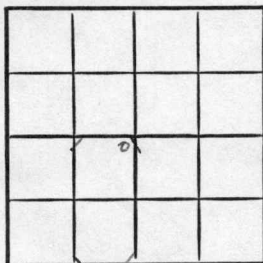

Barton County

Location

Rig up

Drilling and Remarks:

R U R

RECORD

Cased in., ft.

Sand

Gas

Oil

Total Depth

PRODUCTION

1st 24 hrs. Nat.

1st 24 hrs. after shot

Gas Cu. Ft.

Dry Hole

Abandoned

Date


APR 23 1947 19 S. J. LEWIS Scout

Kansas

Map No. K 73 Sec. 12 Twp. 16 R. 13WWell No. 1 PhillipsDerby Drlg. etal. Company**ABANDONED**

Contractor

NE SW

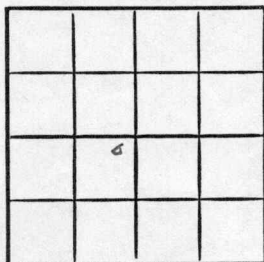E 1/1913
SECTION PLAT330 Ft. from N. Line Ft. from S. Line330 Ft. from E. Line Ft. from W. LineBarton CountyLocation Rig up

Drilling and Remarks:

Re 83366**RECORD**Cased in., ft.Sand Gas Oil Total Depth 3420**PRODUCTION**1st 24 hrs. Nat. 1st 24 hrs. after shot Gas Cu. Ft.Dry Hole Abandoned

Date

MAY 7 1947 19 S. J. LEWIS Scout

O.W.W.O.

FORM 513 SUNRAY

County Barton Elev. _____
 Sec. 12 Twp. 16 Rge. 13W
 Company Haynes Drig. Co.
 FarmName Phillips No. 1

TOPS	DEPTH	LOG	DATUM	Loc. in Sec.
Anh.				NE NE SW
TP.				(OWWO)
H.				O.W.W.O.
Tr.				Geol.
Dg.				Contr.
BL.				
L.				
K.C.				
B.K.C.				
Ce.				
C.				
M.				
M.				Pool
K.				
Mz.				
Mo.				
V. <u>LKC</u>	<u>3106</u>			
S.				
S.	<u>3366</u>			
A.				
R.				
Pf.				
G.				
T.D. <u>OTD</u>	<u>3430</u>			

FIRST REPORT

	0	
		APR 24 '57

Date Comm. Was D & A Phillips (DHM)
 New Info. - MIRT, Drill pipe stuck @ 225

13

County Barton Elev. 1910 DF
 Sec. 12 Twp. 16 Rge. 13W
 Company Haynes Drlg. Co.
 Farm Name Phillips No. 1

TOPS	DEPTH	LOG	DATUM	Loc. in Sec.
Anh.				NE NE SW
Tr.				(OWWO)
H.		3024		
Tr.		3038		
Dg.				
Bl.		3109		
L.		3117		Geol.
K.C.				Contr.
B.K.C. <u>Drum</u>		3245		
Ce.				
C.				
M.				Pool <u>Phillips</u>
M.				
K.				
Mz.				
Mo.				
V. <u>LKC</u>	3106			
S.				
S.				
A.	3366	3364		
R.				
Pe.				
G.				
TD.	<u>OTD</u>	<u>3438 3441</u>		COMPLETE

Date Comm. Was D & A Phillips (DHM)

New Info. - MIRT, Drill pipe stuck @ 225

MAY 1 '57 X ~~4 1/2 @ 3370 - 3400~~ ~~DD~~

CO 3441 PF 3399-3401 FU

2400' wth + scum oil to 50.

MAY 8 '57 4 1/2 @ 3438 S.D. MAY 15 '57

W MAY 22 '57 FU 800' Fluid \$ 8

Boph no/wth (PF'S Leaking?

PKR stuck @ 3370?) Pol

(Arb. oil) MAY 29 '57 JUN 5 '57 P. 40 Boph

no/wth. JUN 12 '57 (Hole in Pipe @ 3380) JUN 19 '57

JUN 26 '57 JUL 3 '57 JUL 10 '57 JUL 17 '57 JUL 24 '57 AUG 31 '57

AUG 13 '57 AUG 14 '57 AUG 21 '57 Phy pmg 97 BOPD + OK

Arb PE Gr 37°

3366-70 Rocker Still in Hole

12-16-1340

NE NE SW