


Section 35 Township 33 Range 3E

Well No. 2 Holman

Company Helmerich & Payne

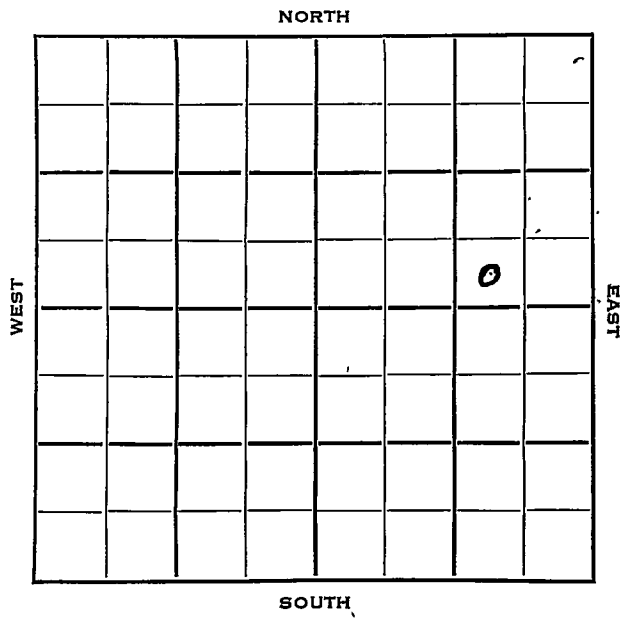

Sec. 35 Twp. 33 R. 3 E

Well No. # 2 Holman Farm

Helmerich & Payne Company


Contractor

Ft. from N. Line

330 Ft. from S. Line

990 Ft. from E. Line

Ft. from W. Line

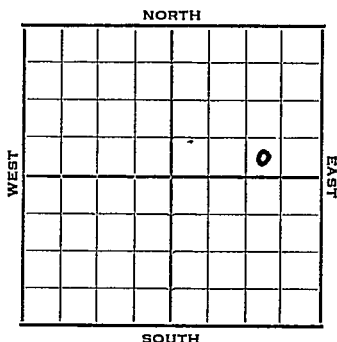

SW SE NE

1952

Elev. - REPORT

11/26

Spud 11-21-52
8" @ 96
Drlg. 2561'

12/10

Spud 11-21-52
D&A
TD 3821'
8" @ 96
Stal 2207, Layton 2615, KC
2817, Oswego 3120, Bart 3290,
Miss 3353
TD 3821
DST 3818-21, opn 2 hrs., wtr.
D&A

ABANDONED

County **Cowley** State **Kansas**

Sec. **35** (Blk. Twp.) **33** (Sur. Rge.) **3E** Map No.

Operator **Helmerich & Payne**

Well No. **2** Farm **Holman**

Elev. Location **SW SE NE**

330 Ft. From **S** Line **NE**

290 Ft. From **E** Line Quarter

1st. Report **NOV 26 1952**

Completion

Remarks

Spudding Date **11-21-52**

Drlg. Data

3" @ 96 drlg. 2561

