

Cowley

FORM 51

KANSAS

Section 35 Township --33 Range 3E

Well No. 3 - Hölman

Company Helmerich & Payne

NORTH

				6					

SOUTH

Sec: 35 Twp. 33 R. 3 E

Well No. # 3 Holman Farm

Helmerich & Payne Company

Warren Pet. Contractor


_____ Ft. from N. Line

990 Ft. from S. Line

_____ Ft. from E. Line

330 Ft. from W. Line

NW SW NE

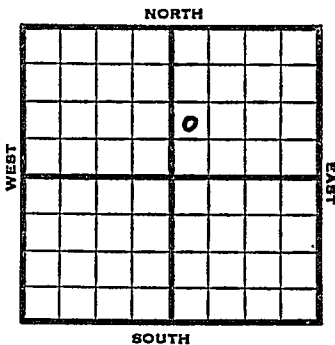

-1953 Elev. 1167' REPORT

1/21 Spud 1-19-53
10" @ 133
Drlg. 680'

6/24 Spud 1-19-53
D&A
TD 3347
10" @ 133
Stal. 2229, Layton 2645, KC 2825,
Oswego 3010, Bart 3343
TD 3347
5" @ 3341
CO to 3347
D-hyro
S/1½ bo 1 bwph
D&A

ABANDONED

