


Section 35 Township 33 Range 3E

Well No. 1 ~~Wright~~ McMichael

Company Mead Production

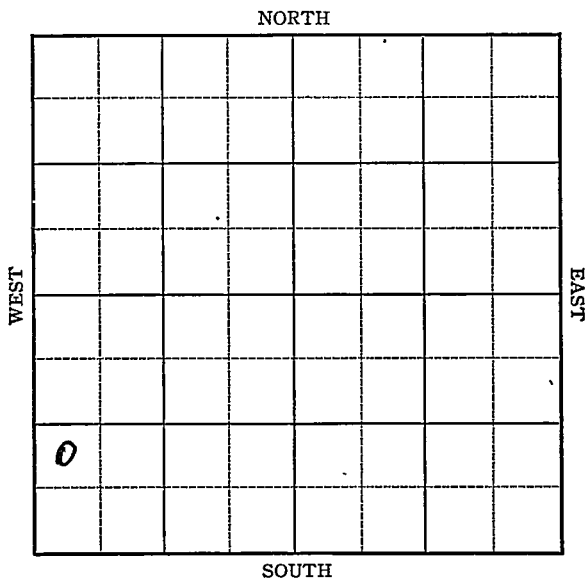

Map No. 1 / Sec. 35 Twp. 33 R. 3EWell No. 1 WrightMead Production

Company

FIRST REPORT

Contractor

SECTION PLAT

NW SW SW

Ft. from N. Line


990

Ft. from S. Line

Ft. from E. Line

330

Ft. from W. Line

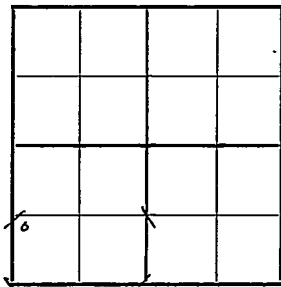

WILDCAT

Location _____

Rig up _____

Drilling and Remarks:

Cellar

RECORD

Cased _____ in., _____ ft.

Sand _____

Gas _____

Oil _____

Total Depth _____

PRODUCTION

1st 24 hrs. Nat. _____

1st 24 hrs. after shot _____

Gas _____ Cu. Ft.

Dry Hole _____

Abandoned _____

Date

JUN 18 194119S. J. LEWIS

Scout

Map No. / Sec. 35 Twp. 33 R. 3E

Well No. 1 McMichael

Mead Production Company

Contractor

ABANDONED

SECTION PLAT

NW SW SW

Ft. from N. Line

990 Ft. from S. Line

Ft. from E. Line

330 Ft. from W. Line

o			

WILDCAT

RECORD

Location

Cased in., ft.

Rig up

Sand

Drilling and Remarks:

Gas

Oil

Miss 3401

Total Depth 2437

Water.

PRODUCTION

1st 24 hrs. Nat.

1st 24 hrs. after shot

Gas Cu. Ft.

Dry Hole

Abandoned

Date

AUG 20 1941 19

S. J. LEWIS Scout