


Section 35 Township 33 Range 3E

Well No. #1 Holman

Company Helmerich & Payne

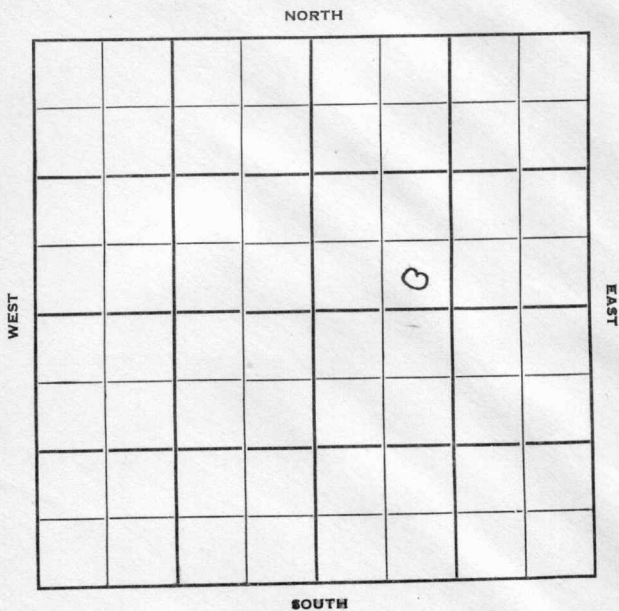

Cowley

KANSAS

Sec. 35 Twp. 33 R. 3E

Well No. #1 Holman Farm

Helmerich & Payne Company

Enterprize Pool Contractor


_____ Ft. from N. Line

330 Ft. from S. Line

_____ Ft. from E. Line

990 Ft. from W. Line

SE SW NE

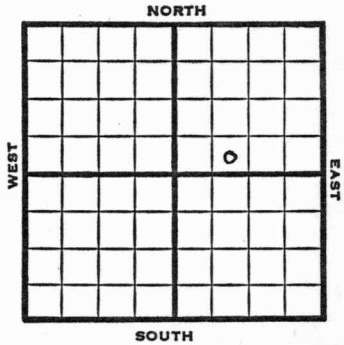

1952

Elev. 1172' REPORT

10/8

Spud 10-4-52
8" @ 115'
Drlg. 1596'

12/17

Spud 10-4-52
Oil Well
TD 3359
8" @ 115
Stal 2216, Layton 2621, KC 2816,
Cherokee 3128, Bart 3332,
TD 3346
5" @ 3324
CO to 3346 sd-frac DD 3359 wtr
PB 3350 2-hydro
F/80 bo 5 hrs.
Comp. 78 bopd 10% wtr.

COMPLETED

