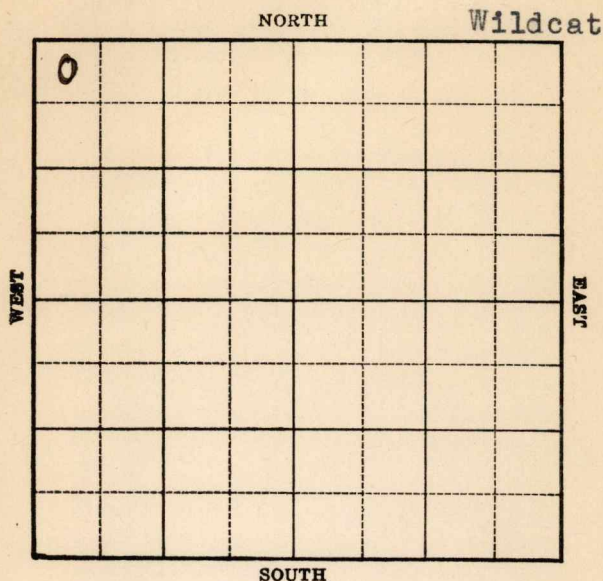


Section 16 Township 29 Range 6-EWell No. 1 HartenbowerCompany C. H. Bechin & Vincent
~~S. L. Carlook et al~~

O. W. D. D

KANSAS

Butler

Sec. 16 Twp. 29 R. 6-EWell No. #1 Hartenbower FarmC. H. Bechini & VincentC. L. Carlock et al

Company

(Wildcat)


330 Ft. from N. Line

Ft. from S. Line

Ft. from E. Line

330 Ft. from W. Line

Elev. 1388

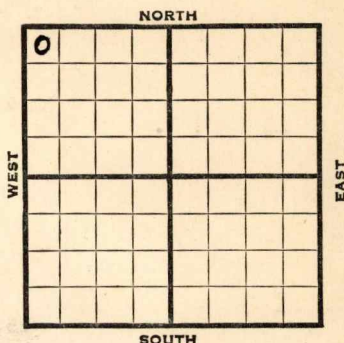

1939

REPORT

O. W. D. D

3/1

C. R.

3/10

"

3/17

Spud.

3/24

15" - 359' Drlg. 475'

3/31

12" - 1130' Drlg. 1300'

4/7

10" - 1765' Drlg. 2060'

4/14

8" - 2409' Sand 2476-2500'

S.S.O. Drlg. 2501'

4/21

Shot 30 qts. 2502' no help.

8" - 2523' Drlg. 2715'

4/26

Arb. 3249'

T. D. 3257'

S. W. 3255'

ABANDONED

1939

O. W. D. D

10/25

Old T.D. 3257'

Cleaning out to test

Peru sand 2476-2500'

OVER

1939			
11/2	Old T.D. 3257'		
	Peru sand 2476-2500'		
	Cleaning out to test.		
11/9	Cleaning out.		
11/16	" " "		
11/23	C.O. 1200'		
11/29	Shut down 1200'		
12/7	" " "		
12/14	" " "		
12/21	" " "		
12/28	" " "		
1940			
1/4	" " "		
1/11	" " "		
1/18	" " "		
1/25	" " "		
2/1	" " "		
2/8	" " "		
2/15	" " "		
2/23	" " "		
2/29	" " "		
3/8	" " "		
3/14	" " "		
3/21	" " "		
3/28	" " "		
4/4	" " "		
4/12	" " "		
4/17	T.D. 3257'		

ABANDONED

Butler

KANSASMap No. 11 Sec. 16 Twp. 29 R. 6EWell No. 1 HartenbowerC. L. Carlock et al Company

Contractor

FIRST REPORT

NW/C

330 Ft. from N. Line Ft. from S. Line Ft. from E. Line330 Ft. from W. Line**WILDCAT****SECTION PLAT**

0			

Location Rig up

Drilling and Remarks:

CR**RECORD**Cased in., ft.Sand Gas Oil Total Depth **PRODUCTION**1st 24 hrs. Nat. 1st 24 hrs. after shot Gas Cu. Ft.Dry Hole Abandoned

Date

MAR 1 - 193919H. D. Hatfield Scout

Butler

KANSAS

Map No. // Sec. 16 Twp. 29 R. 6EWell No. 1 HartenbowerC. L. Carlock etal Company

Contractor

ABANDONED

NW/C

330 Ft. from N. Line Ft. from S. Line Ft. from E. Line330 Ft. from W. Line

Wildcat

SECTION PLAT

0			

Location Rig up

Drilling and Remarks:

S.W 3255D. & A.

RECORD

Cased in., ft.Sand Arb 3249Gas Oil Total Depth 3257

PRODUCTION

1st 24 hrs. Nat. 1st 24 hrs. after shot Gas Cu. Ft.Dry Hole Abandoned

Date

APR 26 1939 19H. D. Hatfield Scout

Map No. 11 Sec. 16 Twp. 29 R. 6EWell No. 1 Hartenbower Est.C. H. Bechin & Vincent Company

CORRECTION

Contractor

NW/C

330 Ft. from N. Line Ft. from S. Line Ft. from E. Line330 Ft. from W. Line

SECTION PLAT

0			

WILDCAT

Location Rig up

Drilling and Remarks:

OWDD-OTD 3257

Cl. Out to test

Peru sd. 2476-
2500

RECORD

Cased in., ft.Sand Gas Oil Total Depth

PRODUCTION

1st 24 hrs. Nat. 1st 24 hrs. after shot Gas Cu. Ft.Dry Hole Abandoned

Date

OCT 25 1939 19 S. J. LEWIS Scout

Map No. 11 Sec. 16 Twp. 29 R. 6EWell No. 1 Hartenbower EstateC.H. Bechin & Vincent Company

Contractor

ABANDONED

SECTION PLAT

°			

NW/C
330 Ft. from N. Line Ft. from S. Line Ft. from E. Line330 Ft. from W. Line

WILDCAT

Location Rig up Drilling and Remarks:

RECORD

Cased in., ft.Sand Gas Oil Total Depth 3252

PRODUCTION

1st 24 hrs. Nat. 1st 24 hrs. after shot Gas Cu. Ft.Dry Hole Abandoned

Date

APR 17 1940

19

S. J. LEWIS

Scout