


Section 35 Township 33 Range 3E

Well No. #1 Wright "G"

Company Helmerich & Payne

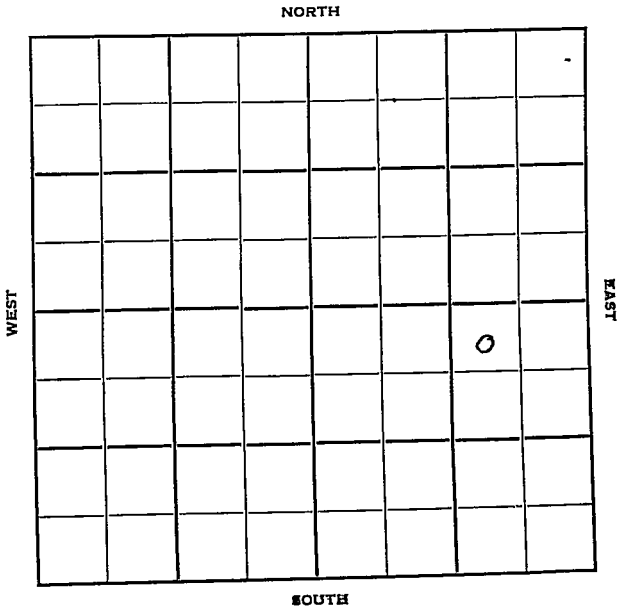

Cowley

KANSAS 3E ✓

Sec. 35 Twp. 33 R. 3E

Well No. #1 Wright "G" Farm

Helmerich & Payne Company

Warren Contractor

Interprise Pool


330 Ft. from N. Line

\_\_\_\_\_ Ft. from S. Line

990 Ft. from E. Line

\_\_\_\_\_ Ft. from W. Line

NW NE SE

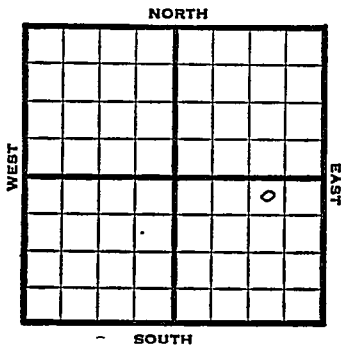

1952 Elev. 1175' REPORT

10/1 Spud 9-26-52  
8" @ 132  
Drlg. 2304

11/5 Spud 9-26-52  
Oil Well TD 3347'  
8" @ 132  
Stal. 2208  
KC 2812  
Cherokee 3130  
5" @ 3336' TD 3347  
S/ 1 boph Hydor.  
Comp. 135 bopd

Layton 2612  
Ft. Scott 3010  
Bart. 3335  
CO to 3337

**COMPLETED**

County **Cowley** State **Kansas**

Sec. **35** (Blk. Twp.) **33** (Sur. Rge.) **3E** Map No.

Operator **Helmerich & Payne**

Well No. **1** Farm **Wright "G"**

Elev. **1175** Location **NW NE SE**


**330** Ft. From **N** Line **SE**

**990** Ft. From **E** Line **Quarter**

1st. Report **OCT 1 1952**

Completion

Remarks

**Warren - Contr.**

Spudding Date **9-26-52**

Drlg. Data **Interprise Pool**

**8" @132 drlg. 2304**

**J. G. McGEHEE**

County Cowley State Kansas

Sec. 35 (Blk. Twp.) 33 (Sur. Rge.) 3E Map No.

Operator Helmerich & Payne

Well No. 1 Farm Wright "G"

Elev. 1175 Location NW NE SE


COMPLETE

330 Ft. From N Line SE

990 Ft. From E Line Quarter

Ist. Report

Completion NOV 5 1952

Remarks Interprise Pool

Warren - Contr.

Spudding Date 9-26-52

Drilg. Data Oil well TD 3347

8" @ 132 Stal. 2208 Layton 2612

KC 2812 Ft. Scott 3010 Cherokee 3130

Bart. 3335 5" @ 3336 TD 3347

CO to 3337 S/ 1 boph Hydro.

Comp. 135 bopd