


SECTION 12 TOWNSHIP 16 RANGE 13W

WELL NO. #2 Phillips

COMPANY Haynes Drlg. Co.

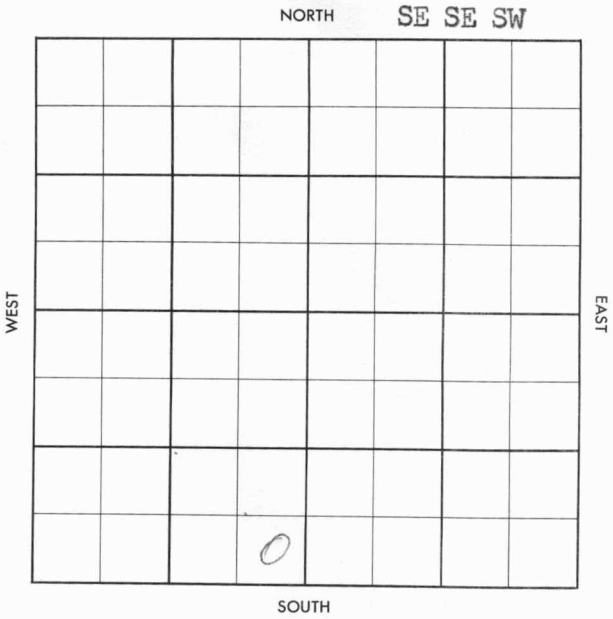

County Barton Elev. \_\_\_\_\_  
 Sec. 12 Twp. 16 Rge. 13W  
 Company Haynes Drlg. Co.  
 Farm Name Phillips No. 2

TOPS	DEPTH	LOG	DATUM	Loc. in Sec.
Anh.				SE SE SW
Tp.				
H.				
Tr.				
Dg.				
Bl.				
L.				Geol. _____
K.C.				Contr. _____
B.K.C.				
Ce.				Co. Tools
C.				
M.				Pool
M.				Phillips
K.				
Mz.				
Me.				
V.				
S.				
S.				
A.				
R.				
Pe.				
G.				
T.D.				

AUG 14 1957  
 FIRST REPORT  
 0

Date Comm. \_\_\_\_\_  
 Location \_\_\_\_\_

13

Co.  
Lse.  
No.  
Sec.  
T.  
R.

County Barton Elev. 1911 DF  
 Sec. 12 Twp. 16 Rge. 13W  
 Company Haynes Drlg. Co.  
 FarmName Phillips No. 2

TOPS	DEPTH	LOG	DATUM
Anb.			
Tp.	2782		
H.	3056		
Tr.	3075		
Dg.			
Bl.	3144		
L.	3154		
K.C.			
B.K.C.			
Ce.			
C.			
M.			
M.			
K.			
Mz.			
Me.			
V.			
S.			
S.			
A	3406		
R.			
PE.			
G.			
T.D.	3440		

Loc. in Sec. SE SE SW  
 Geol. \_\_\_\_\_  
 Contr. \_\_\_\_\_  
 Co. Tools' \_\_\_\_\_  
 Pool \_\_\_\_\_  
 Phillips  
**ABANDONED**  
 SEP 4 '57  
 0

Date Comm. \_\_\_\_\_  
 Location AUG 21 '57 AUG 28 '57 8-24-57

898 250/150 D 1500

SEP 4 '57

DEA

Co.

Loc.

No.

Sec.

T.

R.