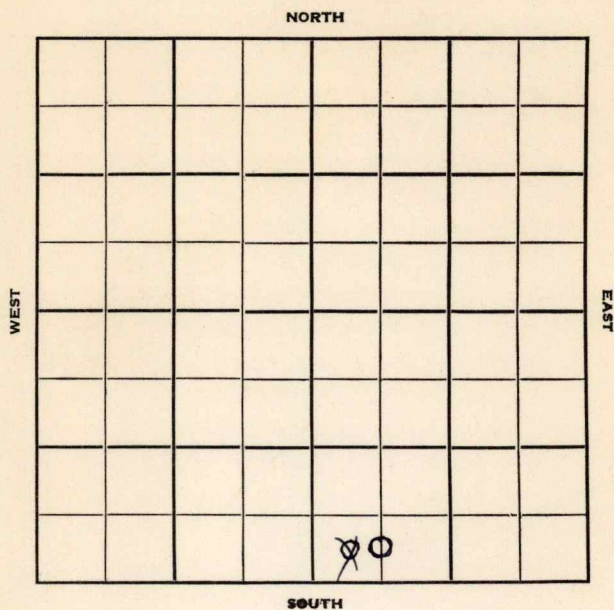


Section 16 Township 29 Range 6 EWell No. # 1 PriceCompany Holcomb et al

Butler

KANSAS

Sec. 16 Twp. 29 R. 6E

Well No. #1 Price Farm

Holcomb et al Company

Myers - Contr. Contractor


 Ft. from N. Line

330' Ft. from S. Line

 Ft. from E. Line

660
330' Ft. from W. Line

CSL SW SE
~~SW SW SE~~

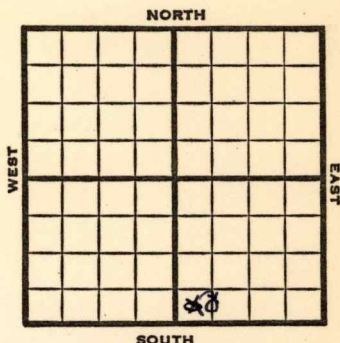

1951

REPORT

Elev. -

5/29

Spud 5-15-51
12" @ 725
10" @ 1515
Drlg. 1580'

6/20

Spud 5-15-51 Oil well TD 2072'
12" @ 725 10" @ 1515' **KC 2062'**
5" @ 2060' TD 2072' 500 A
P/6 BOPD Hydrofrac 1500 A
Comp. 25 BOPD

COMPLETED

K-6825

Map No. _____ Sec. 16 Twp. 29 R. 6EWell No. 1 Price _____Holcomb

Company _____

CORRECTION

Contractor _____

C S L SW SE

SECTION PLAT

_____ Ft. from N. Line

330 Ft. from S. Line

_____ Ft. from E. Line

660 Ft. from W. Line

Butler County

Location _____

Rig up _____

Drilling and Remarks:

Reported

SW SW SE

RECORD

Cased _____ in., _____ ft.

Sand _____

Gas _____

Oil _____

Total Depth _____

PRODUCTION

1st 24 hrs. Nat. _____

1st 24 hrs. after shot _____

Gas _____ Cu. Ft.

Dry Hole _____

Abandoned _____

Date


JUN

26 1951

19

J. E. TYRA

Scout

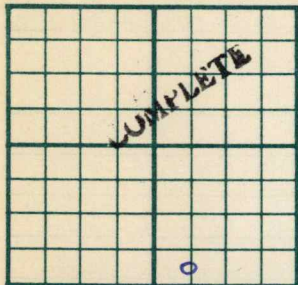County Butler State KansasSec. 16 (Blk. Twp.) 29 (Sur. Rge.) 6E Map No.Operator Holcomb etal.Well No. 1 Farm PriceElev. Location C S L SW SE330 Ft. From S Line SE660 Ft. From W Line Quarter

1st. Report

Completion JUN 20 1951

Remarks

Myers - Contr.Spudding Date 5-15-51Drlg. Data Oil well TD 207212" @ 725 10" @ 1515 KC 20625" @ 2060 TD 2072 500 A P/ 6 bopdHydrofrac 1500 A Comp. 25 bopd

J. E. TYRA