


Barton

Section 14 Township 16 Range 13WWell No. #1 WilbornCompany Adair Oil

NORTH

WEST

EAST

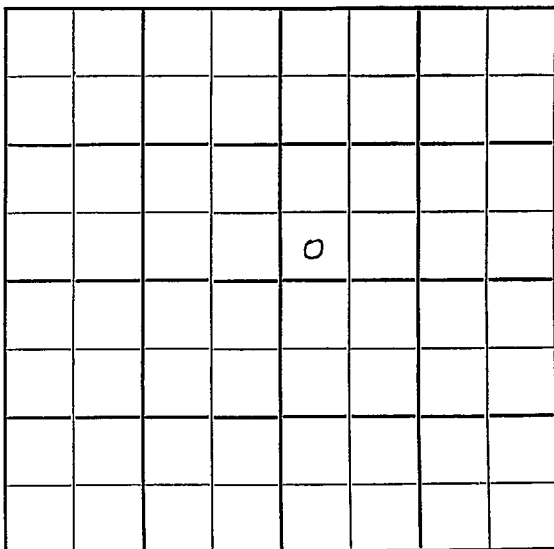

SOUTH

Barton **KANSAS**

Sec. 14 Twp. 16 R. 13W ✓

Well No. #1 Wilborn Farm

Adair Oil Company

Adair Contr. Contractor

Wildcat


 Ft. from N. Line

330' Ft. from S. Line


 Ft. from E. Line

330' Ft. from W. Line

SW SW NE

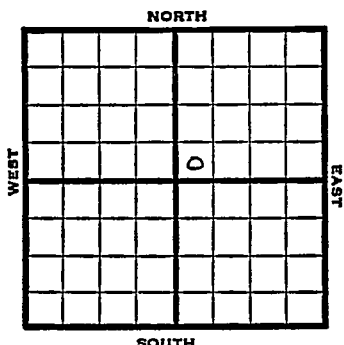

1950	Elev. 1902' REPORT
12/13	Spud 12-9-50 8" @ 244' Drlg. 506'
12/27	Spud 12-9-50 D&A TD 3404 8" @ 244 Anhy 950-55 Top. 2783 Heeb. 3029 Br Lime 3097 Lans. 3113 Cong. 3367 Arb. 3377 TD 3404 D&A ABANDONED

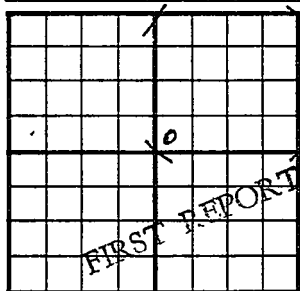
County Barton State KansasSec. 14 (Blk. Twp.) 16 (Sur. Rge.) 13W Map No.Operator Adair OilWell No. 1 Farm WilbornElev. Location SW SW NE330 Ft. From S Line NE330 Ft. From W Line Quarter1st. Report DEC 1 3 1950

Completion

Remarks

Adair - Contr.Spudding Date 12-9-50Drlg. Data Wildcat8" @ 244 drlg. 506

J. E. TYRA

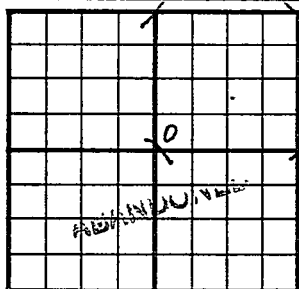County Barton State KansasSec. 14 (Blk. Twp.) 16 (Sur. Rge.) 13W Map No.Operator Adair OilWell No. 1 Farm WilbornElev. 1902 Location SW SWNE330 Ft. From S Line NE330 Ft. From W Line Quarter1st. ReportCompletion DEC 27 1950Remarks WildcatAdair - Contr.Spudding Date 12-9-50Drlg. Data D & A TD 34048" C 244 Anhy 950-55 Top. 2783Heeb. 3029 Br. line 3097 Lans. 3113Cong. 3367 Arb. 3377-3404 TDD & A

J. E. TYRA