


Section 16 Township 16 Range 13-W

Well Number #1-Deutsch

Company C.L. Price

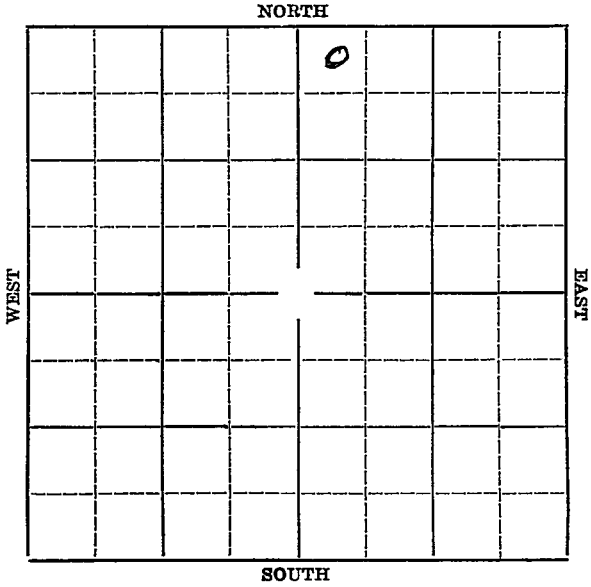

KANSAS

Map No. _____ Sec. 16 Twp. 16 R. 13W

Well No. #1. Deutsch Farm _____

C.I. Price

Company _____


330' Ft. from N. Line

_____ Ft. from S. Line

_____ Ft. from E. Line

330' Ft. from W. Line

Elev 1922

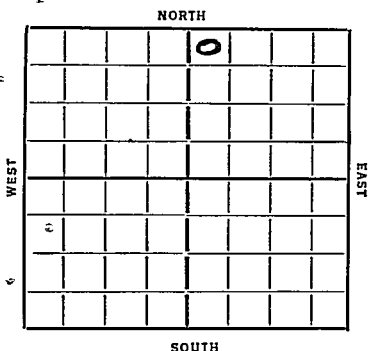

Date	REPORT
1936	
8/5	Rig.
8/13	12" @ 465'. Drlg. 650'.
8/20	Drlg. 1365'. Anhydrate 870'.
8/27	3125' shut down.
9/3--	9/10--9/18--9/24--10/1--
10/8	2420'. under ream 8".
10/15	8" @ 2415'. 2440' shut down.
10/22	Drlg. 2550'.
10/29	Topeka 2820'. Drlg. 3125'.
11/6	Oswald 3135 Show oil 3153
	set 6"
11/12	Shut down.
11/19--	XXX X
11/27	Sil. 3373'. T. D. 3375'.
	Show oil.
12/3	2500' oil in hole 10 days.
12/10	T. D. 3382'. 2800' oil 9 hrs.
	Run tubing.
	OVER

1936

12/17 Sil. 3386'. (Corrected)
T. D. 3390 $\frac{1}{2}$ '. 1000 acid.
Pump 63 bbls. 1st hr.

12/22 Sil. 3386'. 1000 acid.
T. D. 3390 $\frac{1}{2}$ '.
Pot. 939-20 hrs.
37.5 gravity.

COMPLETED

KANSAS

Map No. 73 Sec. 16 Twp. 16 R. 13W

Well No. 1 Deutch

C. L. Price Company

Contractor

SECTION PLAT

		0	

330 Ft. from N. Line

_____ Ft. from S. Line

_____ Ft. from E. Line

330 Ft. from W. Line

FIRST FLOOR

RECORD

Location _____

Cased _____ in., _____ ft.

Rig up _____

Sand _____

Drilling and Remarks:

Gas _____

Rig

Oil _____

Total Depth _____

PRODUCTION

1st 24 hrs. Nat. _____

1st 24 hrs. after shot _____

Gas _____ Cu. Ft.

Dry Hole _____

Abandoned _____

Date

7/29/26 19 19 G. D. Lewis Scout

Caston KANSAS

Map No. 73 Sec. 16 Twp. 16 R. 13W

Well No. 1 Heutsch

C. L. Price Company

Contractor

SECTION PLAT

		0	

330 Ft. from N. Line

_____ Ft. from S. Line

_____ Ft. from E. Line

330 Ft. from W. Line

COMPLETED

Location _____

Rig up _____

Drilling and Remarks:

Sil 3386

1000 acid

P 8939-20 hrs

37.5 gravity

RECORD

Cased _____ in., _____ ft.

Sand _____

Gas _____

Oil _____

Total Depth 3390 1/2

PRODUCTION

1st 24 hrs. Nat. _____

1st 24 hrs. after shot _____

Gas _____ Cu. Ft.

Dry Hole _____

Abandoned _____

Date

DEC 22 1936

S. J. LEWIS

Scout