


Section 30 Township 15 Range 17W

Well No. #1 Laex Leiker

Company N.C.R.A.

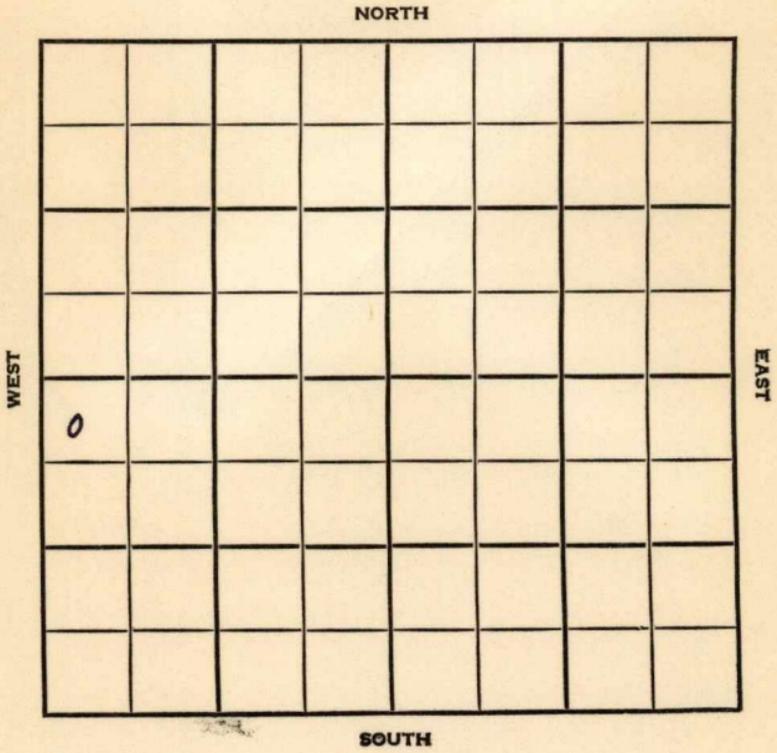

Ellis

KANSAS

SEC.	TWP.	R.
30	15	17 W

WELL NO. # 1 Alex Leiker FARM

COMPANY N C R A

CONTRACTOR Braden Drlg.


S. Wheatland Pool

330 Ft. from N. Line

Ft. from S. Line

Ft. from E. Line

330 Ft. from W. Line

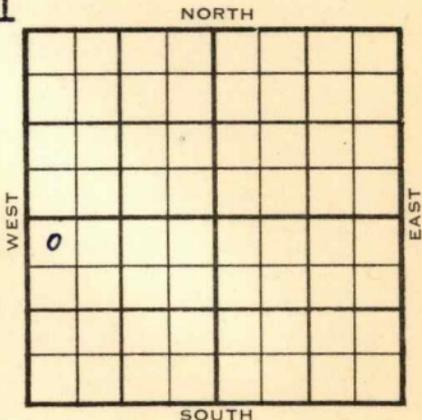

NW NW SW

	ELEVATION	REPORT
1954	Elev. 1950'	
5/19	Spud 5-15-54 8" @ 1106	Anhy 1096' WOC
5/26	Heeb 3201	Lans. 3250' DST 3268-79, 2 hrs, 65' M 940# Drlg. 3365'
6/2	DST 3415-23, 2 hrs, 30' SO & GCM	0# Cong. 3512' Arb. 3542' BST 3543-46, 1 hr, 45' M 900# Granite 3774' RTD 3785 5" @ 3694
6/9	CO 3785' S/40 BWPB 5 hrs.	2000 A S/25 BFPB 2 hrs.
6/15	Spud 5-15-54 Oil Well TD 3785' 8" @ 1106	Anhy 1096', Heeb 3201', Lans 3250' DST 3268-79', opn 2 hrs., rec. 65' mud, 940# DST 3415-23, opn 2 hrs., rec. 30' SO&GCM, 0# Cong 3512', Arb. 3542' DST 3543-46', opn 1 hr., rec. 45' mud, 900# Granite 3774'

OVER

(Information Brought Forward)

1954  
6/15

TD 3785'  
5" @ 3694'  
CO to 3785'  
S/40 bwph 5 hrs., 2000A  
S/25 bfph 2 hrs.  
BB 3742, 2000A  
CO to 3785'  
Comp. for SWD Well

~~ABANDONED~~

ABANDONED



