


Section 35 Township 14 Range 13WWell No. ~~#3 Shaffer~~ #2 Shaffer (A) #2 Shaffer "A"Company Keystone Pet.

NORTH

WEST

EAST

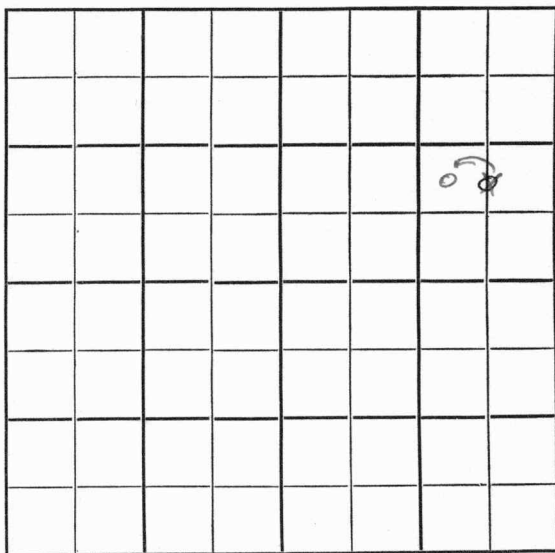

SOUTH

Russell

KANSAS

Sec. 35 Twp. 14 R. 13W

Well No. #2 Shaffer (A) Farm
#2 Shaffer "A"
Keystone Pet. Company

Keystone

Contractor

Hall Gurney


Ft. from N. Line

990 Ft. from S. Line

~~990~~
660 Ft. from E. Line

Ft. from W. Line

~~C N/2 SE NE~~
NW SE NE

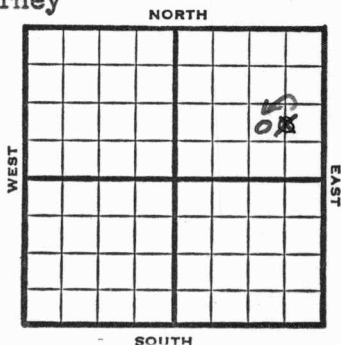

1952

Elev. 1687' REPORT

3/5 Location

3/12 "

3/19 "

3/25 "

4/1 RUST

4/9 "

4/23 15" @ 12'
Anhy 603' 10" @ 605'
Drlg. 1225'

4/30 TD 2130'

5/7 Tar 2181 TD 2187'
5" @ 2182' DP

5/14 Spud 4-10-52
Oil Well TD 2187
15" @ 12' Anhy 603
10" @ 605
Tarkio 2181 TD 2187
S/1 boph 2 hr. Hydro
Comp. 35 bopd

COMPLETED

Map No. _____ Sec. 35 Twp. 14 R. 13W

Well No. 2 Shaffer (A)

Keystone Pet.

Company

CORRECTION

Contractor

NW SE NE

SECTION PLAT

_____ Ft. from N. Line

990 Ft. from S. Line

990 Ft. from E. Line

_____ Ft. from W. Line

			o

Location _____

Rig up _____

Drilling and Remarks:

Reported

C N/2 SE NE

RECORD

Cased _____ in., _____ ft.

Sand _____

Gas _____

Oil _____

Total Depth _____

PRODUCTION

1st 24 hrs. Nat. _____

1st 24 hrs. after shot _____

Gas _____ Cu. Ft.

Dry Hole _____

Abandoned _____

Date

APR 9

1952

19

J. G. McGEHEE

Scout

Kansas

Map No. _____ Sec. 35 Twp. 14 R. 13WWell No. 3 Shaffer

Keystone Pet.

Company _____

CORRECTION

Contractor _____

NW SE NE

1stCorrection in Booklet

SECTION PLAT

_____ Ft. from N. Line

990

Ft. from S. Line

990

Ft. from E. Line

_____ Ft. from W. Line

			0

Russell County

Location _____

Rig up _____

Drilling and Remarks:

Reported

#2 Shaffer "A"

RECORD

Cased _____ in., _____ ft.

Sand _____

Gas _____

Oil _____

Total Depth _____

PRODUCTION

1st 24 hrs. Nat. _____

1st 24 hrs. after shot _____

Gas _____ Cu. Ft.

Dry Hole _____

Abandoned _____

Date

APR 30 1952

19

J. G. McGEHEE

Scout

Map No. _____ Sec. **35** Twp. **14** R. **13W**Well No. **2 Shaffer (A)****Keystone Pet.**

Company

NW SE NE

2nd Correction Ticket
SECTION PLAT

_____ Ft. from N. Line

990 Ft. from S. Line**990** Ft. from E. Line

_____ Ft. from W. Line



Location _____

Rig up _____

Drilling and Remarks:

Was Reported # **2****Shaffer (A)****Corrected to #3****Shaffer (A)****Now Corrected to**
2 Shaffer (A)

RECORD

Cased _____ in., _____ ft.

Sand _____

Gas _____

Oil _____

Total Depth _____

PRODUCTION

1st 24 hrs. Nat. _____

1st 24 hrs. after shot _____

Gas _____ Cu. Ft.

Dry Hole _____

Abandoned _____

Date

MAY 7 1952

19

J. G. McGEHEE


Scout

County Russell State Kansas
 Sec. 35 (Blk. 14 (Sur. 13W Map No. 14)
 (Twp.) (Rge.)

Operator Keystone Pet.

Well No. 2 Farm Shaffer "A"

Elev. 1687 Location NW SE NE

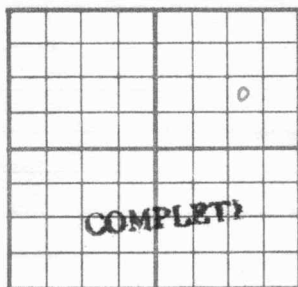

990 Ft. From S Line NE

990 Ft. From E Line Quarter

1st. Report

Completion MAY 14 1952

Remarks Hall-Gurney Pool

Keystone - Contr.

Spudding Date 4-10-52

Drlg. Data Oil well TD 2187

15" @ 12' Anhy 603 10" @ 605

Tarkio 2181 TD 2187 5" @ 2182

CO to 2187 S/ 1 boph 2 hr. Hydro.

Comp. 35 bopd

J. G. McGEHEE

County **Russell** State **Kansas**Sec. **35** (Blk.) **14** (Sur.) **13W** Map No.Operator **Keystone Pet.**Well No. **2** Farm **Shaffer (A)**Elev. Location **C N/2 SE NE**

FIRST REPORT

990 Ft. From **S** Line **NE****660** Ft. From **E** Line Quarter1st. Report **MAR 5 1952**

Completion

Remarks

Keystone - Contr.

Spudding Date

Drlg. Data **Hall Gurney****Location****J. G. McGEHEE**