


Section 30 Township 15 Range 17W

Well No. 1 Leiker "A"

Company Jones, Shelburne & Farmer

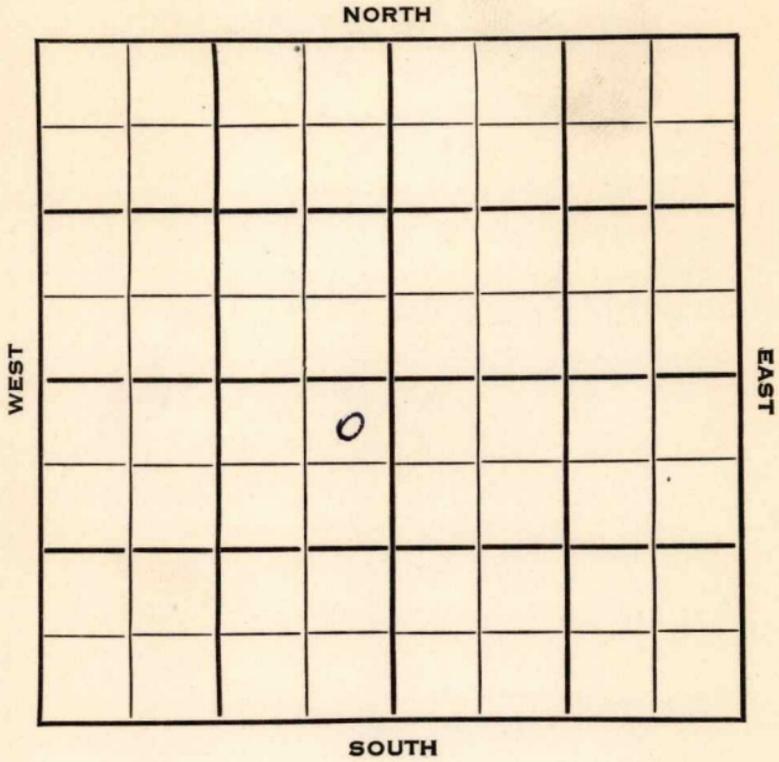

Ellis KANSAS

SEC.	TWP.	R.
30	15	17W

WELL NO. 1 Leiker "A" FARM

COMPANY Jones, Shelburne & Farmer


CONTRACTOR Gabbert-Jones
SW Wheatland Pool

330 Ft. from N. Line

Ft. from S. Line

330 Ft. from E. Line

Ft. from W. Line

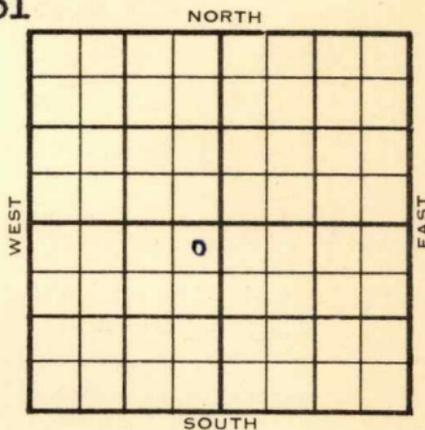

NE NE SW

1953	ELEVATION	REPORT
	1962'	

12/9 Spud 12-2-53
8" @995'
Drlg. 1813'

12/16 Anhy 1115' Heeb 3198' Tor 3219'
Lans. 3248'
DST 3265-77, 1 hr, 150' SW, 3' SOCM
895##
DST 3314-33, 1/2 hr, 15' M O#
Drlg. 3509'

12/22 Spud 12-2-53
D&A
TD 3592'
8" @ 995'
Anhy 1115', Heeb 3198', Tor 3219',
Lans 3248'
DST 3265-77', opn 1 hr., rec. 150' sw,
3' socm, 895#
DST 3314-33, opn 1/2 hrs., rec. 15' mud,
O#
Arb. 3551'
DST 3552-57', opn 1/2 hrs., rec. 15' mud,
1000#
TD 3592'
D&A

ABANDONED

County **Ellis** State **Kansas**

Sec. **30** (Blk. **15**) (Sur. Rge.) **17W** Map No.

Operator **Jones, Shelburne & Farmer**

Well No. **1** Farm **Leiker "A"**

Elev. Location **NE NE SW**

FIRST REPORT					
	0				

330 Ft. From **N** Line **SW**

330 Ft. From **E** Line **Quarter**

1st. Report **DEC 9 1953**

Completion

Remarks

Gabbert-Jones - Contr.

Spudding Date **12-2-53**

Drig. Data **SW Wheatland Pool**

8" @ 995 drlg. 1813

